

LABOR AND MATERIALS


1 Copper } Connection 1 1/2" \$
 Lead }
 1 Curb } Cock } 1 1/2 in. O-r-seal \$
 Valve }
 F-S-&V: }
 1 Service box } Short 3 1/2 x 4 1/2 } O-r-seal
 Old returned } Long 4 1/2 x 5 1/2 } curb box.
 Buff or Rdway }
 17 Ft. 1 1/2 in. } Copper } Pipe at \$
 G.I. }
 G.I. }
 Nipples in. at \$
 Bushings to in. at \$
 Red'g }
 Inc'g } Coupl'gs. to in. at \$
 Union in. at \$
 Meter in. at \$
 Lead Joints at \$
 Compound Joints at \$
 Maintenance Foreman \$
 Hrs. Water Maint. Man-1 at \$
 Hrs. Water Maint. Man-2 at \$
 Hrs. Garage Foreman at \$
 Hrs. Labor at \$
 Hrs. Compressor at \$
 Compensation Ins. at \$ per C. \$
 Trucking \$
 Pav't Patch \$
Tap by Gifford & Co. \$
1-16-67. \$
 O'head \$
 \$

101-113 RIDGE.

St. Ridge
 Pl. 97
 Ave. No.

Name of Owner
Kamyr Inc.

Labor and Mat'l. Report Jan. 16 1967.

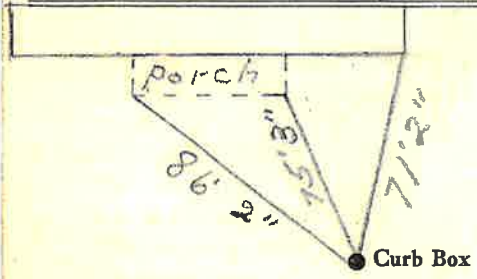

10" Main Elev. of Main at tap 5'

Gate at • Gate at
101
 TAX 10# 303.17-9-3.2

• Curb Box
1 1/2" copper
17' to main