

Labor and Materials

| | | | | | |
|-----------------------|---|-----------------|-----------|--------|----|
| Copper | } | Connection..... | | | \$ |
| Lead | | | | | |
| Curb | } | Cock | in | | \$ |
| | | Valve | | | |
| | | T. S. & V. | | | |
| Service Box | } | Short 3½ x 4½ | } | | \$ |
| Old returned | | Long 4½ x 5½ | | | |
| | | Buff. or Rdway | | | |
| Ft. in. | } | Copper | } Pipe at | | \$ |
| | | Galv Iron | | | |
| | | Cast Iron | | | |
| Nipples | | in. at | | | \$ |
| Bushings | | to | in. at | | \$ |
| Red'g | } | Conplings | to | in. at | \$ |
| Inc'g | | | | | |
| Union | | in. at | | | \$ |
| Meter | | in. at | | | \$ |
| Lead Joints at | | | | | \$ |
| Leadite Joints at | | | | | \$ |
| Hrs. Foreman at | | | | | \$ |
| Hrs. Chauffeur at | | | | | \$ |
| Hrs. Tapper at | | | | | \$ |
| Hrs. Labor at | | | | | \$ |
| Hrs. Labor at | | | | | \$ |
| Hrs. Compressor at | | | | | \$ |
| Compensation Ins. | | | | | \$ |
| Trucking | | | | | \$ |
| Builders Use of Water | | | | | \$ |
| | | | | | \$ |
| | | | | | \$ |
28-69

108-110

Ridge St

St.
Pr

Ave. No. 78


Name of Owner

Ridgerson

Labor and Mat'l. Report

Sept 9

1927

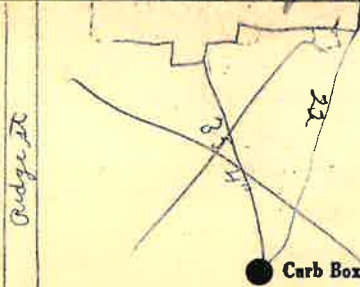

6'

Main

Elev. of

Main at tap 5'

Gate at

Gate at

INSIDE WALK

Curb Box

45 ft. 110 Ridge Curb Box For

Curb Box For