

LABOR AND MATERIALS

_____	Copper } Connection _____	\$ _____
_____	Lead } _____	\$ _____
_____	Curb } Cock Valve } _____ in. _____	\$ _____
_____	_____ } T.S. & V. } _____	\$ _____
_____	Service box { Short 3-1/2 x 4-1/2 } _____	\$ _____
_____	Old returned { Long 4-1/2 x 5-1/2 } _____	\$ _____
_____	Ft. _____ in. { Copper } Pipe at _____	\$ _____
_____	_____ } G.I. } _____	\$ _____
_____	_____ } C.I. } _____	\$ _____
_____	Nipples _____ in. at _____	\$ _____
_____	Bushings _____ to _____ in. at _____	\$ _____
_____	Red'g _____	\$ _____
_____	Inc'g _____	\$ _____
_____	Union _____ in. at _____	\$ _____
_____	Meter _____ in. at _____	\$ _____
_____	_____	\$ _____
_____	Compound Joints at _____	\$ _____
_____	Maintenance Foreman _____	\$ _____
_____	Hrs. Water Maint. Man - 1 at _____	\$ _____
_____	Hrs. Water Maint. Man - 2 at _____	\$ _____
_____	Hrs. Garage Foreman _____ at _____	\$ _____
_____	Hrs. Labor _____ at _____	\$ _____
_____	Hrs. Compressor at _____	\$ _____
_____	_____	\$ _____
_____	Trucking _____	\$ _____
_____	Pav't Patch _____	\$ _____
_____	_____	\$ _____
_____	_____	\$ _____

127
131 RIDGE

St
Pl. Ave. No. _____

Name of Owner

LYK OIL

Labor and Mat'l. Report 19

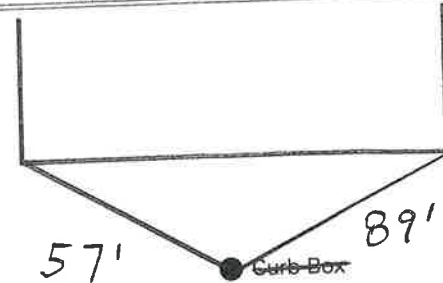

_____ Main Elev. of Main at tap _____

Gate at ●

● Gate at

TAX ID # 303.17-8-12

● Curb Box

RECEIVED

JAN 15 2018

**City of Glens Falls
W.W.T.P.**

Labor and Materials

1	Copper	Connection	3/4"	\$ 2.60
	Lead			
1	Curb	Valve	2 1/2" in.	\$ 2.27
		T.S. & V.		
1	Service Box	Short 3 1/2 x 4 1/2		\$ 1.38
	Old returned	Long 4 1/2 x 5 1/2		
		Buff. or Rdway		
9	Ft.	3/4" in.	Copper Galv. Iron Pipe at	\$ 1.62
			Cast Iron	
	Nipples	in. at		\$
	Bushings	to in. at		\$
1	Red'g	Couplings	7/8" to 1/2" in. at	\$ 1.0
	Lead			
	Union	in. at		\$
	Meter	in. at		\$
	Lbs. Br. Stone	at		\$
	Lbs. Sand	at		\$
	Bags Cement	at		\$
	Paving Brick	Mack Red Asphalt	at	\$
	Lead Joints	at		\$
	Leadite Joints	at		\$
5 1/2	Hrs. Foreman	at		\$ 3.44
2 1/2	Hrs. Common Labor	at Tapper		\$ 1.25
12 1/2	Hrs. Common Labor	at		\$ 5.63
	Hrs. Mason	at		\$
	Hrs. Mason's Helper	at		\$
1	Hrs. Compressor	at		\$ 1.50
	Compensation Ins			\$.27
	Trucking			\$ 1.00
	Builders' Use of Water			\$ 23.00
Total				\$ 44.11

31-157. 122-131

Labor and Material Report

1931

3/4" tap at 93 Ridge at

Esso Station

Door | Door | Door

129-131

70'4"

73'6"

Curb Box

8 Main

Elev of Main at tap

Gate at

Gate at

Curb Box

Old tap about off

Getty Good Mart.

3/4" Copper

9' to main