

LABOR AND MATERIALS


_____ Copper } Connection _____ \$ _____	
_____ Lead } _____	
_____ Curb } Cock Valve } _____ in. _____ \$ _____	
	T.S. & V. }
_____ Service box { Short 3-1/2 x 4-1/2 } _____ \$ _____	
_____ Old returned { Long 4-1/2 x 5-1/2 } _____	
_____ Ft. _____ in. { Copper } Pipe at _____ \$ _____	
	{ G.I. }
	{ C.I. }
_____ Nipples _____ in. at _____ \$ _____	
_____ Bushings _____ to _____ in. at _____ \$ _____	
_____ Red'g _____	
_____ Inc'g _____	
_____ Union _____ in. at _____ \$ _____	
_____ Meter _____ in. at _____ \$ _____	
_____ _____ \$ _____	
_____ Compound Joints at _____ \$ _____	
_____ Maintenance Foreman _____ \$ _____	
_____ Hrs. Water Maint. Man - 1 at _____ \$ _____	
_____ Hrs. Water Maint. Man - 2 at _____ \$ _____	
_____ Hrs. Garage Foreman _____ at _____ \$ _____	
_____ Hrs. Labor _____ at _____ \$ _____	
_____ Hrs. Compressor at _____ \$ _____	
_____ _____ \$ _____	
_____ Trucking _____ \$ _____	
_____ Pav't Patch _____ \$ _____	
_____ _____ \$ _____	
_____ _____ \$ _____	
133 RIDGE

SP
Pl.
Ave. No. _____

Name of Owner _____

Labor and Mat'l. Report 19

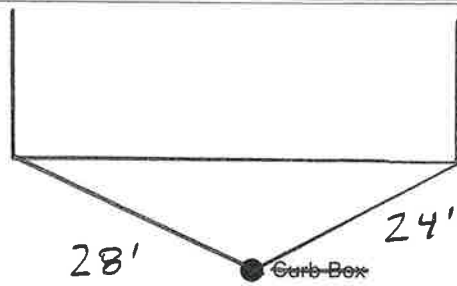

CLEANOUT

_____ Main Elev. of Main at tap _____
 Gate at ● Gate at ●

TAX ID # 303.17-8-11

● Curb Box

RECEIVED

JAN 15 2018

**City of Glens Falls
W.W.T.P.**

Labor and Materials

1	Copper	Connection	3/4"	\$ 2.60
	Lead			
1	Curb	Cock Valve T-S & V.	3/4" in.	\$ 2.27
1	Service Box	Short 3/4" x 4 1/2"		\$ 1.59
	Old returned	Long 4 1/2" x 5 1/2"	Bull. or Redway	
15	Fl.	3/4" in.	Copper Galv. Iron Cast Iron	Pipe at \$ 2.70
	Nipples		in. at	\$
1	Bushings	3/4" to 1/2"	in. at	\$.05
	Red'g Inc'g	Couplings	to in. at	\$
	Union		in. at	\$
	Meter		in. at	\$
	Lbs. Br. Stone	at		\$
	Lbs. Sand	at		\$
	Bags Cement	at		\$
	Paving Brick	Mack Red Asphalt	at	\$
	Lead Joints	at		\$
	Leadite Joints	at		\$
5 1/2	Hrs. Foreman			\$ 3.44
2 1/2	Hrs. Common Labor	Tapper		\$ 1.25
12 1/2	Hrs. Common Labor			\$ 5.63
	Hrs. Mason	at		\$
	Hrs. Mason's Helper	at		\$
1	Hrs. Compressor	at		\$ 1.50
	Compensation Ins.			\$ 32
	Trucking			\$ 1-
	Builders' Use of Water	Patch		\$ 23-

Total \$ 45.35

31-153 133

Labor and Material Report

1911

3/4" Tap at 75' Ridge at



133

Curb Box

Main

Elev of Main at tap

Gate at

Gate at

Curb Box

Old tap shut off

3/4" copper

15' to main