

LABOR AND MATERIALS


_____	Copper } Connection _____	\$ _____
_____	Lead } _____	\$ _____
_____	Curb } Cock _____	\$ _____
_____	Valve } _____ in.	\$ _____
_____	T.S. & V. } _____	\$ _____
_____	Service box { Short 3-1/2 x 4-1/2 } _____	\$ _____
_____	Old returned { Long 4-1/2 x 5-1/2 } _____	\$ _____
_____	Ft. _____ in. { Copper } Pipe at _____	\$ _____
_____	{ G.I. } _____	\$ _____
_____	{ C.I. } _____	\$ _____
_____	Nipples _____ in. at _____	\$ _____
_____	Bushings _____ to _____ in. at _____	\$ _____
_____	Red'g _____	\$ _____
_____	Inc'g _____	\$ _____
_____	Union _____ in. at _____	\$ _____
_____	Meter _____ in. at _____	\$ _____
_____	_____	\$ _____
_____	Compound Joints at _____	\$ _____
_____	Maintenance Foreman _____	\$ _____
_____	Hrs. Water Maint. Man - 1 at _____	\$ _____
_____	Hrs. Water Maint. Man - 2 at _____	\$ _____
_____	Hrs. Garage Foreman _____ at _____	\$ _____
_____	Hrs. Labor _____ at _____	\$ _____
_____	Hrs. Compressor at _____	\$ _____
_____	_____	\$ _____
_____	_____	\$ _____
_____	Trucking _____	\$ _____
_____	Pav't Patch _____	\$ _____
_____	_____	\$ _____
_____	_____	\$ _____
137 RIDGE

St. Pl. Ave. No. _____

Name of Owner _____

Labor and Mat'l. Report 19 _____

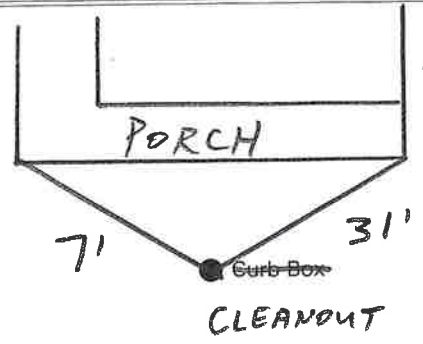

_____ Main Elev. of Main at tap _____

Gate at ● Gate at ●

TAX ID# 303.17-8-10

● Curb Box

RECEIVED

JAN 15 2018

**City of Glens Falls
W.W.T.P.**

LABOR AND MATERIALS


1	Copper Lead	Connection	3/4"	\$	2.41
1	Curb	Cock Valve T.S. & V.	3/4 in.	\$	3.41
Same	Service box	Short 3 1/2 x 4 1/2		\$	
	Old returned	Long 4 1/2 x 5 1/2		\$	
		Buff or Rdway		\$	
8	Ft. 3/4 in.	Copper Pipe at	40	\$	3.20
	Nipples	in. at		\$	
	Bushings	to in. at		\$	
	Red'g Inc'g	Coupl'gs to in. at		\$	
	Union	in. at		\$	
	Meter	in. at		\$	
	Lead Joints at			\$	
	Compound Joints at			\$	
	Maintenance Foreman			\$	0
	Hrs. Water Maint. Man-1 at			\$	
7	Hrs. Water Maint. Man-2 at	1.24		\$	8.68
	Hrs. Garage Foreman at			\$	
18	Hrs. Labor	at 1.13		\$	20.34
	Hrs. Compressor at			\$	
	Compensation Ins. at \$	2.861 per C		\$	1.17
	Trucking			\$	1.50
	Pav't Patch			\$	1.20
	Tap by Gissard 11/19-20/54			\$	
	O'head			\$	
				\$	47.86

40.66

St. 1358
 Pl. Ave. No. 137

Ridge
 Name of Owner
 Dr. Hughes

Labor and Mat'l. Report Nov. 19-20 1954

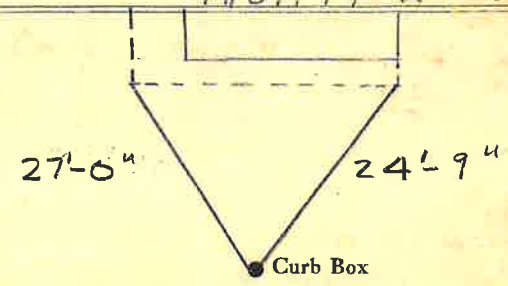

6" Main Elev. of Main at tap 5'
 Gate at • Gate at

3/4" COPPER
 8' to MAIN • Curb Box

Remeasured 6-25-75