

31-159 . 140 RIDGE ST
 Labor and Material Report 12 1931

3/4" tap at 93 Ridge-st

porch

See below.

8 Main Elev of Main at tap 42.28

Gate at ● 3/4" copper ● Gate at
 25' to MAIN

STOP IN CURB → ● Curb Box

Old tap shut off.


Old had conn disconn.

House
 1964

140 RIDGE Pl. Ave. No. _____

Name of Owner _____

Labor and Mat'l. Report 19

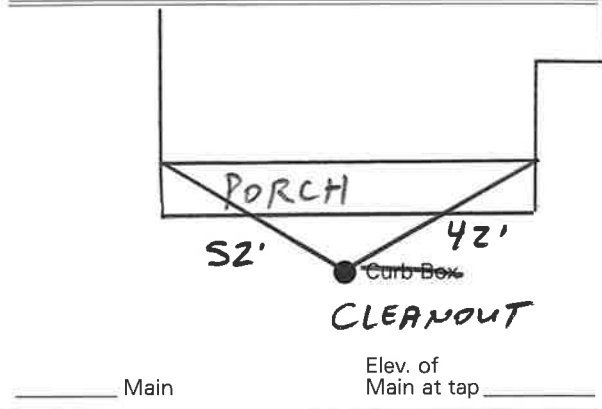

Gate at ● Gate at

TAX ID # 302.20-11-2

● Curb Box

RECEIVED

JAN 15 2018

**City of Glens Falls
 W.W.T.P.**

Labor and Materials

1	Copper } Connection <u>3/4"</u>	\$ 2.60
1	Lead } Connection <u>3/4"</u>	\$ 2.27
1	Curb { Cock Valve } <u>3/4"</u> in.	\$ 1.59
1	Service Box } Short <u>3 1/2 x 4 1/2</u>	\$ 4.50
	Old returned } Long <u>4 1/2 x 5 1/2</u>	\$.95
		\$ 1.5
25	Ft. <u>3/4"</u> in. } Copper Galv. Iron } Pipe at	\$.05
1	Nipples <u>3/4"</u> in. at	\$ 1.5
1	Bushings <u>1"</u> to <u>3/4"</u> in. at (<u>1-1 bushings</u>)	\$.05
	Red'g } Couplings to in. at	\$
	Inc'g } Couplings to in. at	\$
	Union in. at	\$
	Meter in. at	\$
	Lbs. Br. Stone at	\$
	Lbs. Sand at	\$
	Bags Cement 'at	\$
	Paving Brick { Mack Red Asphalt } at	\$
	Lead Joints at	\$
	Leadite Joints at	\$
21	Hrs. Foreman at	\$ 13.13
11	Hrs. Common Labor at <u>TAPPER</u>	\$ 5.50
33	Hrs. Common Labor at	\$ 14.85
	Hrs. Mason at	\$
	Hrs. Mason's Helper at	\$
4	Hrs. Compressor at	\$ 6.00
	Compensation Ins	\$ 1.00
	Trucking	\$ 1.00
	Builders' Use of Water <u>Patch</u>	\$ 46.00
	Total	\$ 98.66

LABOR AND MATERIALS

Copper } Connection _____	\$ _____
Lead } Connection _____	\$ _____
Curb { Cock Valve } _____ in.	\$ _____
	T.S. & V. } _____
Service box { Short 3-1/2 x 4-1/2 }	\$ _____
Old returned { Long 4-1/2 x 5-1/2 }	\$ _____
Ft. _____ in. { Copper } Pipe at _____	\$ _____
	G.I. } _____
	C.I. } _____
Nipples _____ in. at _____	\$ _____
Bushings _____ to _____ in. at _____	\$ _____
Red'g	
Inc'g	
Union _____ in. at _____	\$ _____
Meter _____ in. at _____	\$ _____
_____	\$ _____
Compound Joints at _____	\$ _____
Maintenance Foreman _____	\$ _____
Hrs. Water Maint. Man - 1 at _____	\$ _____
Hrs. Water Maint. Man - 2 at _____	\$ _____
Hrs. Garage Foreman _____ at _____	\$ _____
Hrs. Labor _____ at _____	\$ _____
Hrs. Compressor at _____	\$ _____
_____	\$ _____
Trucking _____	\$ _____
Pav't Patch _____	\$ _____
_____	\$ _____
_____	\$ _____
