


27-41-199  
Labor and Material Report May 19 1927

3/4 tap at 100 Ridge St

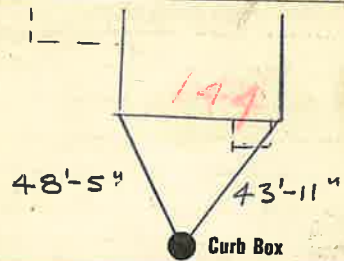

8" Main Elev. of Main at tap 660  
Gate at ● Gate at ●

● Curb Box

Old tap shut off  
Pavement

Remeasured 6-25-75


3/4" copper  
26 to main

144 RIDGE

St  
Pl.  
Ave. No.

Name of Owner

Labor and Mat'l. Report 19

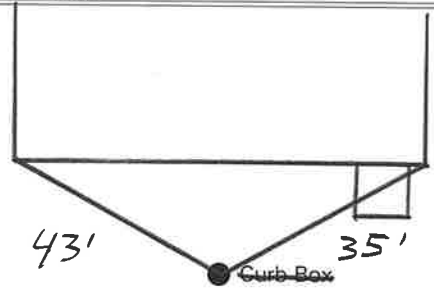

Main Elev. of Main at tap  
Gate at ● Gate at ●

TAX ID # 302.20-11-3

● Curb Box

**RECEIVED**  
**JAN 15 2018**  
**City of Glens Falls**  
**W.W.T.P.**

