


147 RIDGE



Pl. Ave. No.

Name of Owner

Labor and Mat'l. Report 19

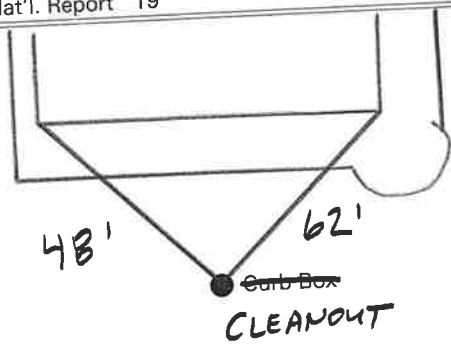

Main

Elev. of Main at tap

Gate at

Gate at

TAX ID# 303.17-1-23

Curb Box

RECEIVED

JAN 15 2018

**City of Glens Falls
W.W.T.P.**

St. Pl.


147

Ave. No.

105

Name of Owner

Labor and Mat'l. Report Sept. 16 1964

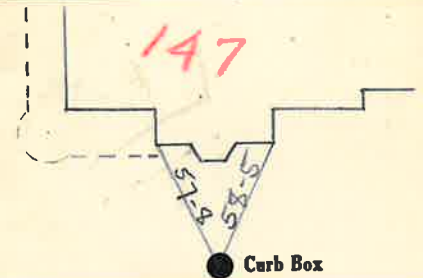

6" - 1964

Main Numan St.

Elev. of Main at tap

Gate at

Gate at

Curb Box

Tap on Numan St,
3/4" copper
10' to main

