


31-161 - 148
Labor and Material Report June 12 1931

3/4" tap at 104 Ridge st

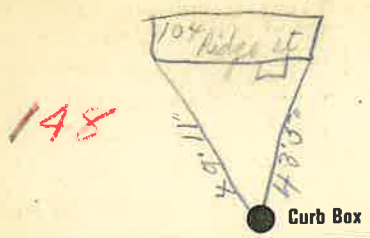


6" Main
Elev of Main at tap 41/2 10
Gate at ● Gate at ●

● Curb Box
Old tap shut off
3/4" Copper
28' to main

148 RIDGE
Pl. Ave. No. _____
Name of Owner _____

Labor and Mat'l. Report 19

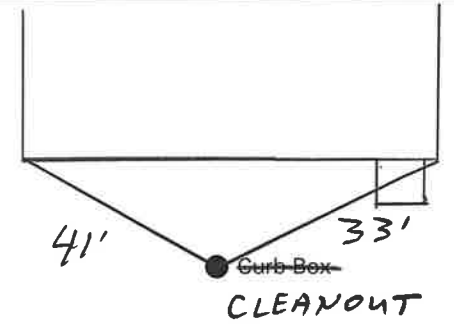

● Curb Box
Elev. of Main at tap _____
Gate at ● Gate at ●

TAX ID # 302.20-11-5

● Curb Box

RECEIVED
JAN 15 2018
City of Glens Falls
W.W.T.P.

