

LABOR AND MATERIALS

| | | | | |
|----|-------------------------|---------------------|-----------------|----|
| 1 | Copper | Connection | 3/4" | \$ |
| 1 | Curb | Cock | 3/4 in. OXISEAL | \$ |
| 1 | Service box | Short 3 1/2 x 4 1/4 | | |
| | Old returned | Long 4 1/2 x 5 1/2 | | \$ |
| 17 | Ft. 3/4 in. | Copper | Pipe at | \$ |
| | Nipples | in. at | | \$ |
| | Bushings | to in. at | | \$ |
| | Red'g | | | |
| | Inc'g | Coupl'gs to in. at | | \$ |
| | Union | in. at | | \$ |
| | Meter | in. at | | \$ |
| | Lead Joints | at | | \$ |
| | Compound Joints | at | | \$ |
| | Maintenance Foreman | | | \$ |
| | Hrs. Water Maint. Man-1 | at | | \$ |
| | Hrs. Water Maint. Man-2 | at | | \$ |
| | Hrs. Garage Foreman | at | | \$ |
| | Hrs. Labor- | at | | \$ |
| | Hrs. Compressor | at | | \$ |
| | Compensation Ins. at \$ | per C | | \$ |
| | Trucking | | | \$ |
| | Pav't Patch | | | \$ |
| | TAP BY PUYVIS & CO | | | \$ |
| | MAY-15-1976 | | | \$ |
| | O'head | | | \$ |

Ridge


St. Pt. Ave. No. 149

Name of Owner

Philip Whittemore

Labor and Mat'l. Report

MAY 15 1976

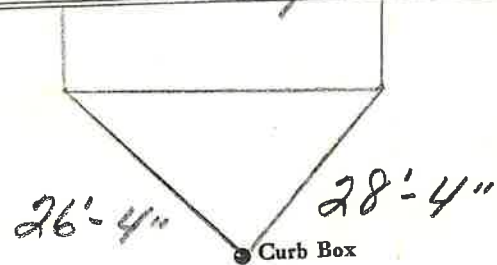

6" Main

Elev. of Main at tap 5"

Gate at • 149-151

• Gate at

TAX ID# 303.17-1-22

3/4" copper
17' to main

• Curb Box