


150 RIDGE

Pl. Ave. No.

Name of Owner

Labor and Mat'l. Report 19

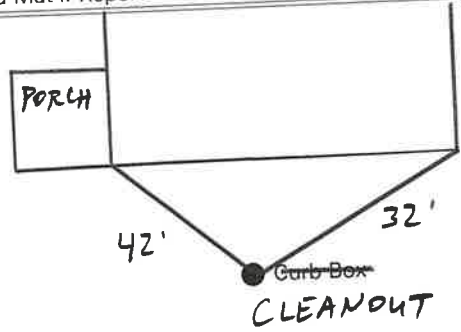

Main Elev. of Main at tap

Gate at ● ● Gate at

● Curb Box

**RECEIVED**  
**JAN 15 2018**  
**City of Glens Falls**  
**W.W.T.P.**


31-70 150

Labor and Material Report Line 12

1931

3/4" tap at 106 Ridge st

150

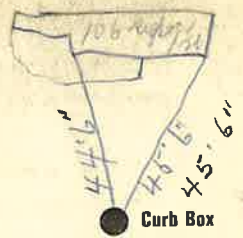

6" Main Elev of Main at tap 4 1/2 ft

Gate at ● ● Gate at

● Curb Box

Old tap shut off  
 3/4" COPPER  
 28' to MAIN

## LABOR AND MATERIALS

Copper } Lead }	Connection _____	\$ _____
Curb } } Cock } Valve } T.S. & V. }	_____ in. _____	\$ _____
Service box Old returned	{ Short 3-1/2 x 4-1/2 } { Long 4-1/2 x 5-1/2 }	\$ _____
Ft. _____ in.	{ Copper } G.I. } C.I. }	Pipe at _____ \$ _____
Nipples _____	in. at _____	\$ _____
Bushings _____	to _____ in. at _____	\$ _____
Red'g _____		
Inc'g _____		
Union _____	in. at _____	\$ _____
Meter _____	in. at _____	\$ _____
_____		\$ _____
Compound Joints at _____		\$ _____
Maintenance Foreman _____		\$ _____
Hrs. Water Maint. Man - 1 at _____		\$ _____
Hrs. Water Maint. Man - 2 at _____		\$ _____
Hrs. Garage Foreman _____ at _____		\$ _____
Hrs. Labor _____ at _____		\$ _____
Hrs. Compressor at _____		\$ _____
_____		\$ _____
Trucking _____		\$ _____
Pav't Patch _____		\$ _____
_____		\$ _____
_____		\$ _____
_____		\$ _____
_____		\$ _____

## Labor and Materials

1 Copper } } Lead }	Connection <u>3/4"</u>	\$ <u>2.60</u>
1 Curb } } Cock } Valve } T.S. & V. }	_____ in. <u>3/4"</u>	\$ <u>2.27</u>
1 Service Box Old returned	{ Short <u>3 1/2 x 4 1/2</u> } { Long <u>4 1/2 x 5 1/2</u> } } Buff or Rdway }	\$ <u>1.59</u>
<u>28</u> Ft. <u>3/4"</u> in.	{ Copper } Galv. Iron } Cast Iron }	Pipe at _____ \$ <u>5.04</u>
Nipples _____	in. at _____	\$ _____
Bushings _____	to _____ in. at _____	\$ _____
Red'g } Inc'g }	Couplings _____ to _____ in. at _____	\$ _____
Union _____	in. at _____	\$ _____
Meter _____	in. at _____	\$ _____
Lbs. Br. Stone at _____		\$ _____
Lbs. Sand at _____		\$ _____
Bags Cement 'at _____		\$ _____
Paving Brick } } Mack } Red } Asphalt }	at _____	\$ _____
Lead Joints at _____		\$ _____
Leadite Joints at _____		\$ _____
<u>1.0</u> Hrs. Foreman at _____		\$ <u>6.25</u>
<u>6</u> Hrs. Common Labor at _____	<u>Tapper</u>	\$ <u>3.00</u>
<u>2.5</u> Hrs. Common Labor at _____	<u>45</u>	\$ <u>11.25</u>
Hrs. Mason at _____		\$ _____
Hrs. Mason's Helper at _____		\$ _____
<u>3</u> Hrs. Compressor at _____		\$ <u>4.50</u>
Compensation Ins _____		\$ <u>63</u>
Trucking _____		\$ <u>1.00</u>
Builders' Use of Water <u>Patch</u>		\$ <u>23.00</u>

Total \$ 61.13