

LABOR AND MATERIALS


_____	Copper } Connection _____	\$ _____
_____	Lead } _____	\$ _____
_____	Curb } Cock _____	\$ _____
_____	Valve } _____ in. _____	\$ _____
_____	T.S. & V. } _____	\$ _____
_____	Service box { Short 3-1/2 x 4-1/2 } _____	\$ _____
_____	Old returned { Long 4-1/2 x 5-1/2 } _____	\$ _____
_____	Ft. _____ in. { Copper } Pipe at _____	\$ _____
_____	{ G.I. } _____	\$ _____
_____	{ C.I. } _____	\$ _____
_____	Nipples _____ in. at _____	\$ _____
_____	Bushings _____ to _____ in. at _____	\$ _____
_____	Red'g _____	\$ _____
_____	Inc'g _____	\$ _____
_____	Union _____ in. at _____	\$ _____
_____	Meter _____ in. at _____	\$ _____
_____	_____	\$ _____
_____	Compound Joints at _____	\$ _____
_____	Maintenance Foreman _____	\$ _____
_____	Hrs. Water Maint. Man - 1 at _____	\$ _____
_____	Hrs. Water Maint. Man - 2 at _____	\$ _____
_____	Hrs. Garage Foreman _____ at _____	\$ _____
_____	Hrs. Labor _____ at _____	\$ _____
_____	Hrs. Compressor at _____	\$ _____
_____	_____	\$ _____
_____	Trucking _____	\$ _____
_____	Pav't Patch _____	\$ _____
_____	_____	\$ _____
_____	_____	\$ _____
_____	_____	\$ _____
_____	_____	\$ _____

10 RIDGE

St.
Pl.
Ave. No.

Name of Owner _____

Labor and Mat'l. Report 19 _____

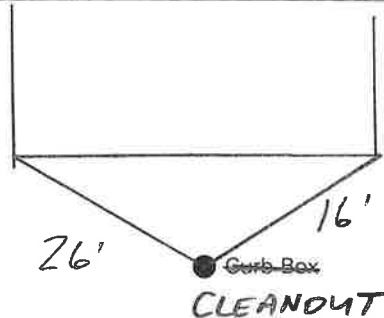

_____ Main Elev. of Main at tap _____

Gate at ● Gate at ●

● Curb Box

RECEIVED

JAN 15 2018

**City of Glens Falls
W.W.T.P.**

Labor and Materials

4-2-1927

1	Copper } Connection	<i>Split Tee</i>		\$ 48.05
	Lead }			
1	Curb } Curb	<i>6"</i>	in.	\$
1	Service Box } Short 3' x 4'	<i>Gate</i>		\$ 7.50
	Old returned } Long 4' x 5'			
26	Ft. 6" in.	Copper Galv. Iron	Pipe at	<i>204</i> \$53.04
	Nipples		in. at	\$
	Bushings		to in. at	\$
	Red'g } Couplings		to in. at	\$
	Inc'g }			
	Union		in. at	\$
	Meter		in. at	\$
	Lbs. Br. Stone		at	\$
	Lbs. Sand		at	\$
	Bags Cement		at	\$
	Paving Brick } Mack		at	\$
		Red		
		Asphalt		
<i>95</i>	Lead Joints at	<i>12 1/2</i>		\$ 11.88
<i>16</i>	Leadite Joints at	<i>30</i>		\$ 45
<i>12</i>	Hrs. Foreman at	<i>6 1/2</i>		\$ 7.50
<i>3 1/2</i>	Hrs. Common Labor at	<i>6 1/2</i>		\$ 20.00
<i>2.3</i>	Hrs. Common Labor at	<i>50</i>		\$ 11.50
<i>4.8</i>	Hrs. Mason at	<i>40 1/8</i>		\$ 19.50
	Hrs. Mason's Helper at			\$
<i>5</i>	Hrs. Compressor at	<i>2.00</i>		\$ 10.00
	Compensation Ins.			\$ 1.58
	Trucking			\$ 10.00
	Builders' Use of Water			\$
				Total \$

192.00 (PUT IN)

27-171

Labor and Material Report *Out 3* 1927

Meynaber Rd Bridge St



46' 8"

45' 7"

● Curb Box

10" Main

Elev. of Main at tap *511*

Gate at ●

● Gate at

88

● Curb Box

6" Tap
26' to MAIN

