

32-123 **161** Part 11 1932
Labor and Material Report

115 Ridge St

12 Main Elev. of Main at tap 4-5

Gate at ● Gate at ●

● Curb Box


New House
 Tap on Morgan Ave
 3/4" - 8' copper

Q1-416

161 RIDGE **ST**
 Pl. Ave. No.

Name of Owner
TAX ID # 303.13-23-16

Labor and Mat'l. Report 19

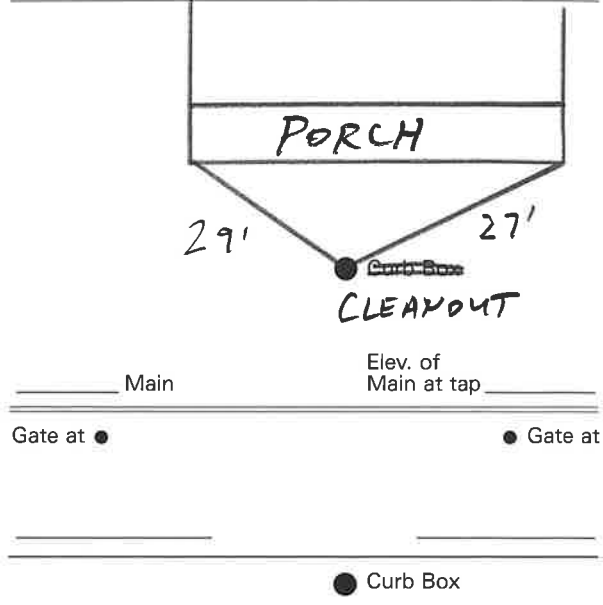

RECEIVED

JAN 15 2018

**City of Glens Falls
 W.W.T.P.**

