


28-164 163
Labor and Material Report Dec 10 19

117 Ridge

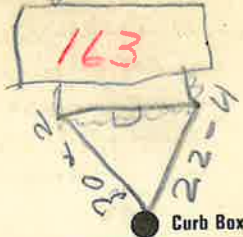

6" Main Elev of Main at tap 5
Gate at ● Gate at ●

● Curb Box


Old tap shut off
3/4" - 15' copper

163 RIDGE

ST
Pl. Ave. No.

Name of Owner
TAX ID # 303.13-23-15

Labor and Mat'l. Report 19

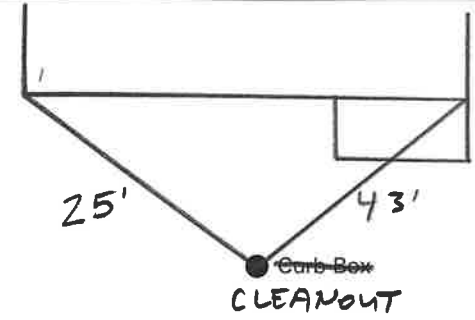

Main Elev. of Main at tap
Gate at ● Gate at ●

● Curb Box

RECEIVED

JAN 15 2018

City of Glens Falls
W.W.T.P.

