


31-163 165
Labor and Material Report June 12 1931

3/4 tap at 119 Ridge st

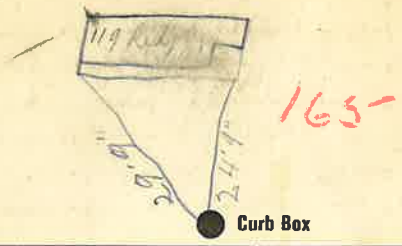

6" Main Elev of Main at tap 4261
Gate at ● Gate at ●

● Curb Box


Old tap shut off

3/4" - 15' COPPER

165 RIDGE Pl. Ave. No. 67

Name of Owner
TAX ID # 303.13-23-14

Labor and Mat'l. Report 19

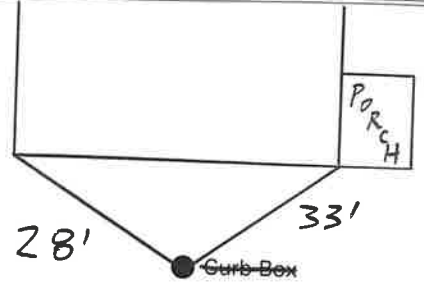

6" Main Elev. of Main at tap
Gate at ● Gate at ●

● Curb Box

RECEIVED
JAN 15 2018
City of Glens Falls
W.W.T.P.

