


166 RIDGE

St.
Pl.
Ave. No.

Name of Owner

TAX ID # 302.16-21-1

Labor and Mat'l. Report 19

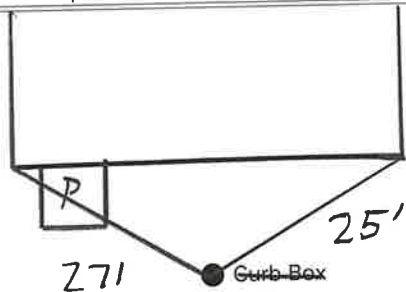

CLEANOUT

Main

Elev. of
Main at tap

Gate at ●

● Gate at

● Curb Box

RECEIVED

JAN 15 2018

**City of Glens Falls
W.W.T.P.**

132


166

Labor and Material Report

Nov 13

1986

120 Ridge St. 3/4" Tap

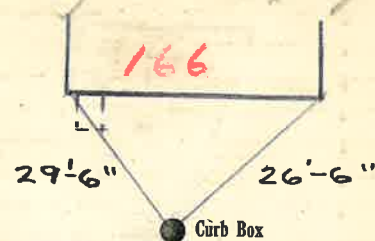

6"

Main

Elev. of
Main at tap

4

Gate at ●

● Gate at

● Curb Box

Old tap shut off

Remeasured 4-1-80

LSH

3/4" - 34' COPPER

LABOR AND MATERIALS

Copper	}	Connection	_____	\$	
Lead					
Curb	}	Cock Valve	_____	in.	\$
	}	T.S. & V.			
Service box	}	Short 3-1/2 x 4-1/2	_____	\$	
Old returned	}	Long 4-1/2 x 5-1/2			
Ft. _____ in.	}	Copper G.I. C.I.	_____	Pipe at	\$
Nipples		_____ in.	_____	at	\$
Bushings		_____ to _____ in.	_____	at	\$
Red'g					
Inc'g					
Union		_____ in.	_____	at	\$
Meter		_____ in.	_____	at	\$
			_____	\$	
Compound Joints at		_____	_____	\$	
Maintenance Foreman		_____	_____	\$	
Hrs. Water Maint. Man - 1 at		_____	_____	\$	
Hrs. Water Maint. Man - 2 at		_____	_____	\$	
Hrs. Garage Foreman		_____ at	_____	\$	
Hrs. Labor		_____ at	_____	\$	
Hrs. Compressor at		_____	_____	\$	
			_____	\$	
Trucking		_____	_____	\$	
Pav't Patch		_____	_____	\$	
			_____	\$	
			_____	\$	
Labor and Materials

1 Copper	}	Connection	_____	\$	
Lead					
1 Curb	}	Cock Valve	_____	in.	\$
	}	T.S. & V.			
1 Service Box	}	Short 3 1/2 x 4 1/2	_____	\$	
Old returned	}	Long 4 1/2 x 5 1/2			
34 Ft. _____ in.	}	Copper G.I. Cast Iron	_____	Pipe at	\$
Nipples		_____ in.	_____	at	\$
Bushings		_____ to _____ in.	_____	at	\$
Red'g					
Inc'g					
Union		_____ in.	_____	at	\$
Meter		_____ in.	_____	at	\$
			_____	\$	
Lbs. Br. Stone at		_____	_____	\$	
Lbs. Sand at		_____	_____	\$	
Bags Cement at		_____	_____	\$	
Paving Brick		{ Mack Red Asphalt }	_____	at	\$
Lead Joints at		_____	_____	\$	
Leadite Joints at		_____	_____	\$	
Hrs. Foreman at		_____	_____	\$	
Hrs. Common Labor at		_____	_____	\$	
Hrs. Mason at		_____	_____	\$	
Hrs. Masons Helper at		_____	_____	\$	
Hrs. Compressor at		_____	_____	\$	
Compensation Ins		_____	_____	\$	
Trucking		_____	_____	\$	
Builders Use of Water		_____	_____	\$	
Total \$.....					