


175 RIDGE

SP
PI.
Ave. No.

Name of Owner

TAX ID# 303.13-16-14

Labor and Mat'l. Report 19

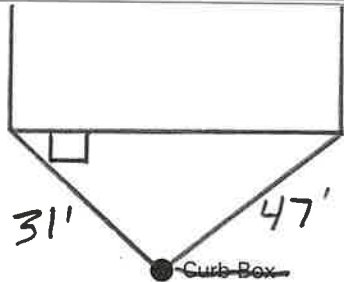

C

Main

Elev. of
Main at tap

Gate at ●

● Gate at

● Curb Box

RECEIVED

JAN 15 2018

City of Glens Falls
W.W.T.P.

31-165

~~175-175~~


Labor and Material Report

June 13

1931

3/4" tap at 129 Ridge at

~~175-175~~

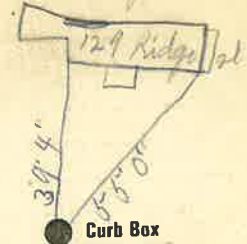

6" Main

Elev of
Main at tap

4 1/2 ft

Gate at ●

● Gate at

● Curb Box

Old tap shut off

3/4" - 15' COPPER

