


176 RIDGE

Pl. Ave. No.

Name of Owner

TAX ID # 302.16-21-5

Labor and Mat'l. Report 19

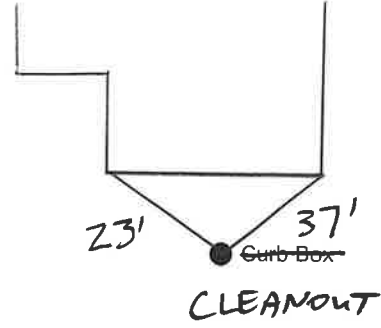

_____ Main Elev. of Main at tap _____


Gate at ● ● Gate at

● Curb Box

RECEIVED
JAN 15 2018
 City of Glens Falls
 W.W.T.P.

1935-70-176
 Labor and Material Report July 24 1935

3/4" tap at 130 Ridge st

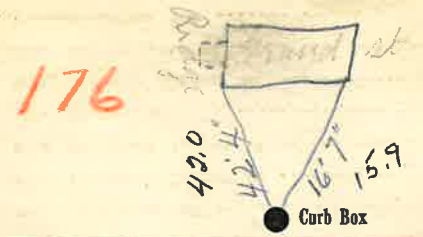

4" gal Main Elev of Main at tap 41.5

Gate at ● ● Gate at

● Curb Box

Old tap shut off at main

2 Holes Tap in new place.

Tap on Grand st side.

3/4" - 10' copper

LABOR AND MATERIALS

_____	Copper } Connection _____	\$ _____
_____	Lead } _____	\$ _____
_____	Curb { Cock Valve } _____ in.	\$ _____
	{ T.S. & V. }	
_____	Service box { Short 3-1/2 x 4-1/2 } _____	\$ _____
_____	Old returned { Long 4-1/2 x 5-1/2 }	\$ _____
_____	Ft. _____ in. { Copper } Pipe at _____	\$ _____
	{ G.I. }	
	{ C.I. }	
_____	Nipples _____ in. at _____	\$ _____
_____	Bushings _____ to _____ in. at _____	\$ _____
_____	Red'g _____	
_____	Inc'g _____	
_____	Union _____ in. at _____	\$ _____
_____	Meter _____ in. at _____	\$ _____
_____	_____	\$ _____
_____	Compound Joints at _____	\$ _____
_____	Maintenance Foreman _____	\$ _____
_____	Hrs. Water Maint. Man - 1 at _____	\$ _____
_____	Hrs. Water Maint. Man - 2 at _____	\$ _____
_____	Hrs. Garage Foreman _____ at _____	\$ _____
_____	Hrs. Labor _____ at _____	\$ _____
_____	Hrs. Compressor at _____	\$ _____
_____	_____	\$ _____
_____	Trucking _____	\$ _____
_____	Pav't Patch _____	\$ _____
_____	_____	\$ _____
_____	_____	\$ _____
Labor and Materials

_____	Copper } Connection ^{3/4"} _____	\$ 1.25
_____	Lead } _____	
_____	Curb { Cock Valve } ^{3/4"} in _____	\$ 1.70
	{ T.S. & V. }	
_____	Service Box { Short 3 1/2 x 4 1/2 } _____	\$ 1.37
_____	Old returned { Long 4 1/2 x 5 1/2 } _____	
	{ Buff. or Rdw. }	
_____	Ft. ^{2 1/4"} in. { Copper } Pipe at ^{1 3/4"} _____	\$ 1.25
	{ Galv. Iron }	
	{ Cast Iron }	
_____	Nipples _____ in. at _____	\$ _____
_____	Bushings _____ to _____ in. at _____	\$ _____
_____	Red'g } Couplings _____ to _____ in. at _____	\$ _____
	Inc'g }	
_____	Union _____ in. at _____	\$ _____
_____	Meter _____ in. at _____	\$ _____
_____	Lbs. Br. Stone at _____	\$ _____
_____	Lbs. Sand at _____	\$ _____
_____	Bags Cement at _____	\$ _____
_____	Paving Brick { Mack Red Asphalt } at _____	\$ _____
_____	Lead Joints at _____	\$ _____
_____	Leadite Joints at _____	\$ _____
3	Hrs. Foreman at ^{62.12} _____	\$ 1.88
6	Hrs. Common Labor at ⁵⁰ _____	\$ 3.50
9	Hrs. Common Labor at ⁴⁵ _____	\$ 3.60
_____	Hrs. Mason at _____	\$ _____
_____	Hrs. Masons Helper at _____	\$ _____
_____	Hrs. Compressor at _____	\$ _____
_____	Compensation Ins _____	\$ 3.20
_____	Trucking _____	\$ 1.00
_____	Builders Use of Water Patch _____	\$ 1.00
Total \$		25.47