

LABOR AND MATERIALS

Copper	} Connection	_____	\$ _____	
Lead				
Curb	} Cock	_____ in.	\$ _____	
				} Valve
Service box	} Short 3½ x 4½	_____	\$ _____	
				Old returned
7 Ft.	1 in.	} Copper	} Pipe at _____	
				} G.I.
		} G.I.		
Nipples	_____ in.		at _____	\$ _____
Bushings	_____ to _____	in. at _____	\$ _____	
Red'g	} Coupl'gs	_____ to _____	in. at _____	\$ _____
Inc'g				
Union	_____ in.	at _____	\$ _____	
Meter	_____ in.	at _____	\$ _____	
			\$ _____	
Compound Joints	at _____		\$ _____	
Maintenance Foreman			\$ _____	
Hrs. Water Maint. Man-1	at _____		\$ _____	
Hrs. Water Maint. Man-2	at _____		\$ _____	
Hrs. Garage Foreman	at _____		\$ _____	
Hrs. Labor	_____ at _____		\$ _____	
Hrs. Compressor	at _____		\$ _____	
			\$ _____	
Trucking			\$ _____	
Pav't Patch			\$ _____	
			\$ _____	
			\$ _____	
			\$ _____	
			\$ _____	

CRN. OF DIX + RIDGE

RIDGE


St. ~~PT.~~  
Ave. No. 177-79

Name of Owner

179-TAX ID # 303 13-116-13

Labor and Mat'l. Report

19 96

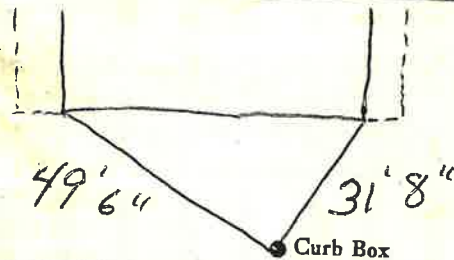

6" Main

Elev. of Main at tap 4½'

Gate at •

• Gate at

1" copper • Curb Box

TAP ON RIDGE

7' to main