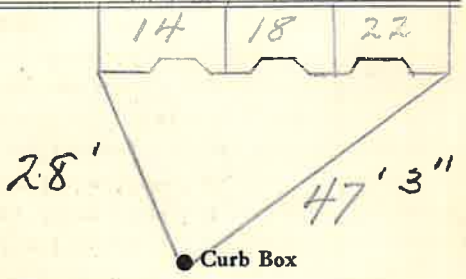



V
 Ridge St. 14-22
Pl. 14-22
Ave. No. _____
 Name of Owner P. Maynehan Est.
 Labor and Mat'l. Report Mar. 16 19 60.

 10" Main Elev. of Main at tap 5 1/2'
 Gate at • • Gate at
 • Curb Box
 2" Tap,
 37' to main
 LSM-5C-2-5 56

14 RIDGE

St. 14-22
 Pl. 14-22
 Ave. No. _____

Name of Owner _____

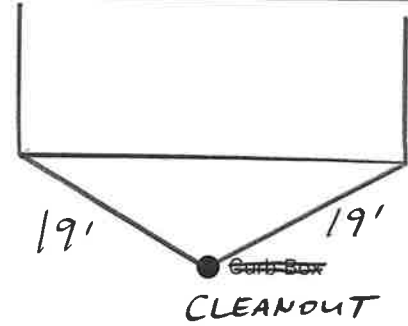Labor and Mat'l. Report 19 _____



Main Elev. of Main at tap _____
 Gate at • • Gate at

14-16

TAX ID# 302.20-30-1

● Curb Box

RECEIVED

JAN 15 2018

**City of Glens Falls
W.W.T.P.**

LABOR AND MATERIALS

1 Copper } Connection 2" \$ _____
 Lead }
 1 Curb } Cock } 2 in. \$ _____
 Valve }
 T.S. & V. }
 1 Service box { Short 3 1/2 x 4 1/2 } \$ _____
 Old returned { Long 4 1/2 x 5 1/2 }
 { Buff or Rdway }
 37 Ft. 2 in. { Copper } Pipe at \$ _____
 { G.I. }
 { C.I. }
 Nipples _____ in. at \$ _____
 Bushings _____ to _____ in. at \$ _____
 1 Red'g } Coupl'gs Cop. to Cop. 2" in. at \$ _____
 Inc'g }
 Union _____ in. at \$ _____
 Meter _____ in. at \$ _____
 Lead Joints at \$ _____
 Compound Joints at \$ _____
 Maintenance Foreman \$ _____
 Hrs. Water Maint. Man-1 at \$ _____
 Hrs. Water Maint. Man-2 at \$ _____
 Hrs. Garage Foreman _____ at \$ _____
 Hrs. Labor _____ at \$ _____
 Hrs. Compressor at \$ _____
 Compensation Ins. at \$ _____ per C \$ _____
 Trucking \$ _____
 Pav't Patch \$ _____
 1 - Male Adapter - 2" \$ _____
 \$ _____
 \$ _____
 \$ _____
 O'head \$ _____
 \$ _____

LABOR AND MATERIALS

Copper } Connection _____ \$ _____
 Lead }
 Curb } Cock } _____ in. \$ _____
 Valve }
 T.S. & V. }
 Service box { Short 3-1/2 x 4-1/2 } \$ _____
 Old returned { Long 4-1/2 x 5-1/2 }
 Ft. _____ in. { Copper } Pipe at \$ _____
 { G.I. }
 { C.I. }
 Nipples _____ in. at \$ _____
 Bushings _____ to _____ in. at \$ _____
 Red'g _____
 Inc'g _____
 Union _____ in. at \$ _____
 Meter _____ in. at \$ _____
 _____ \$ _____
 Compound Joints at \$ _____
 Maintenance Foreman \$ _____
 Hrs. Water Maint. Man - 1 at \$ _____
 Hrs. Water Maint. Man - 2 at \$ _____
 Hrs. Garage Foreman _____ at \$ _____
 Hrs. Labor _____ at \$ _____
 Hrs. Compressor at \$ _____
 _____ \$ _____
 Trucking \$ _____
 Pav't Patch \$ _____
 _____ \$ _____
 _____ \$ _____
