


Ridge

St. ~~Pl.~~
Ave. No. 184

Name of Owner

PATTERSON

Labor and Mat'l. Report May 17 1929

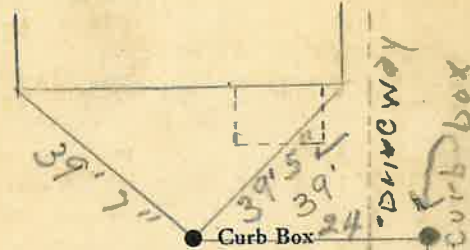

6" Main

Elev. of Main at tap 5

Gate at ●

● Gate at

28' to MAIN

● Curb Box

Curb box changed
 From Drive Way to center
 of house 4-26-51-RAM
 24' COPPER FROM OLD STOP
 UNDER DRIVEWAY TO NEW
 BOX.


184 RIDGE

St.
Pl.
Ave. No.

Name of Owner

TAX ID # 302.16-17-3

Labor and Mat'l. Report 19

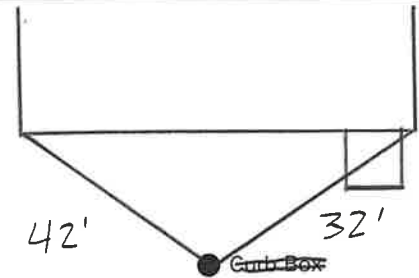

CLEANOUT

Main

Elev. of Main at tap

Gate at ●

● Gate at

● Curb Box

RECEIVED

JAN 15 2018

City of Glens Falls
W.W.T.P.

LABOR AND MATERIALS

Copper	}	Connection	\$
Lead			
Curb	}	Cock Valve	in. \$
		T. S. & V.	
Service box Old returned	}	Short 3½x4½	\$
		Long 4½x5½	
		Buff or Rdway	
Ft. in.	}	Copper	Pipe at \$
		G. I.	
		C. I.	
Nipples	in. at	\$	
Bushings	to in. at	\$	
Red'g	}	Coupl'gs	to in. at \$
Inc'g			
Union	in. at	\$	
Meter	in. at	\$	
Lead Joints	at	\$	
Compound Joints	at	\$	
Hrs. Water Maint. Man—1	at	\$	
Hrs. Water Maint. Man—2	at	\$	
Hrs. Labor	at	\$	
Hrs. Labor	at	\$	
Hrs. Compressor	at	\$	
Compensation Ins.	at \$ per C.	\$	
Trucking		\$	
Pav't Patch		\$	
<i>Used 24' ¾" Copper</i>			
<i>1-¾" Curb & 1-¾" Adapter</i>			
<i>To enter service from driveway</i>			
O'head	<i>To center of house</i>	\$	
		\$	

LABOR AND MATERIALS

Copper	}	Connection	\$
Lead			
Curb	}	Cock Valve	in. \$
		T.S. & V.	
Service box Old returned	}	Short 3-1/2 x 4-1/2	\$
		Long 4-1/2 x 5-1/2	
Ft. in.	}	Copper	Pipe at \$
		G.I.	
		C.I.	
Nipples	in. at	\$	
Bushings	to in. at	\$	
Red'g			
Inc'g			
Union	in. at	\$	
Meter	in. at	\$	
		\$	
Compound Joints	at	\$	
Maintenance Foreman		\$	
Hrs. Water Maint. Man - 1	at	\$	
Hrs. Water Maint. Man - 2	at	\$	
Hrs. Garage Foreman	at	\$	
Hrs. Labor	at	\$	
Hrs. Compressor	at	\$	
		\$	
Trucking		\$	
Pav't Patch		\$	
		\$	
		\$	
		\$	
		\$	


Labor and Materials

1	Copper	Connection	3/4	\$	2.60
1	Lead				
1	Curb	Cock Valve	3/4 in.	\$	2.30
		T-S & V.			
1	Service Box	Short 3/4x1 1/2		\$	1.40
	Old returned	Long 1 1/2x5 1/2			
		Buff. or Rdway			
28	Ft.	3/4 in.	Copper Galv. Iron Pipe at	\$	7.24
			Cast Iron		
	Nipples	in. at		\$	
1	Bushings	3/4 to 1/2 in. at		\$	1.0
	Red'g Inc'g	Couplings	to in. at	\$	
	Union	in. at		\$	
	Meter	in. at		\$	
	Lbs. Br. Stone	at		\$	
	Lbs. Sand	at		\$	
	Bags Cement	at		\$	
	Paving Brick	Mack Red Asphalt	at	\$	
	Lead Joints	at		\$	
	Leadite Joints	at		\$	
7	Hrs. Foreman	at		\$	5.00
29	Hrs. Common Labor	at		\$	11.78
	Hrs. Common Labor	at		\$	
	Hrs. Mason	at		\$	
	Hrs. Mason's Helper	at		\$	
	Hrs. Compressor	at		\$	
	Compensation Ins.			\$	44
	Trucking			\$	1.00
	Builders' Use of Water	Patch		\$	25.00
				Total \$	56.86

29-00 : 184
Labor and Material Report

May 17 1929

136 Ridge St.

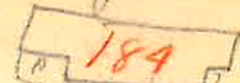

Curb Box

6" Main

Elev of Main at tap 5

Gate at ●

● Gate at

● Curb Box

Old tap shut off

Original Tap

May 17-29.