
196 Ridge St. Ave. No. _ Outside Clean out Labor and Mat'l. Report * 3/9/12 Out side cleanout is on William St. · clean out Dendend manhole manhole Gate at Gate at . TAX 10 # 302.16-16-1 Curb Box

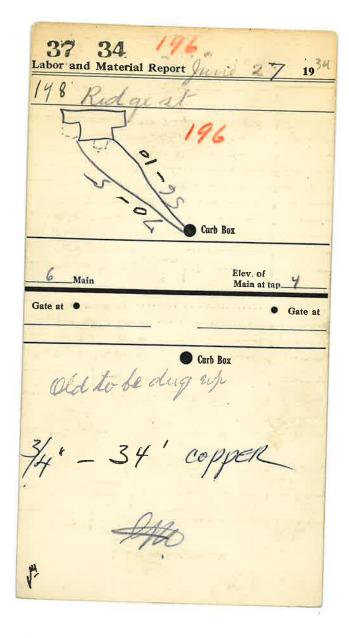

LABOR AND MATERIALS

Copper Connection	\$
Curb Curb Cock Valve T.S. & V.	
Service box Short 3-1/2 x 4-1/2 Old returned Long 4-1/2 x 5-1/2	\$
(Copper)	\$
Nipples in. at	\$
Bushings to in. at	
Red'g	
Inc'g	
Union in. at	\$
Meter in. at	
Compound Joints at	_ \$
Maintenance Foreman	
Hrs. Water Maint. Man - 1 at	
Hrs. Water Maint. Man - 2 at	
Hrs. Garage Foreman at	
Hrs. Labor at	
Hrs. Compressor at	
	\$
Trucking	\$
Pav't Patch	

	\$
	\$

Labor and Materials

Labor and Materials
Copper Connection
Curb Curb in
[Short 314x416]
(Copper
Galv. Iron Pipe at
Bushingstoin. at\$
Red'g Couplingstoin.at\$
Unionin. at\$
Lbs. Br. Stone at\$
Lbs. Sand at
Paving Brick Red Asphalt at\$
Leadite Joints at\$
1. Hrs. Foreman at
15. Hrs. Common Labor at45\$\$
Hrs. Mason at\$
Hrs. Compressor at\$
Compensation Ins\$.1.07
Builders Use of Water Part Pale s.g.
Total \$.55.05