


31-170 **199**
Labor and Material Report June 18 1931

3/4" tap at 151 Ridge at

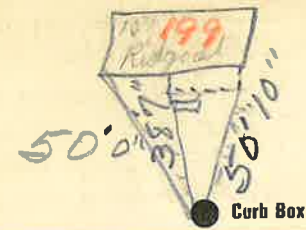

6" Main Elev of Main at tap 4'2"
Gate at ● Gate at ●

● Curb Box


Old tap shut off

3/4" - 14' COPPER

199 RIDGE St
Pl. Ave. No. _____

Name of Owner _____
TAX ID # 303.13-8-20

Labor and Mat'l. Report 19

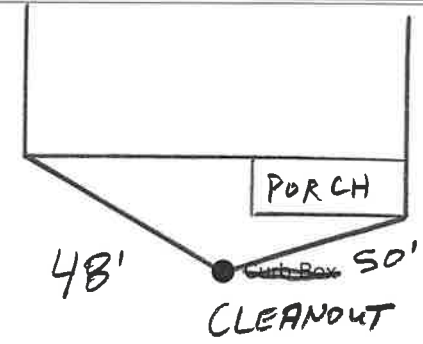

_____ Main Elev. of Main at tap _____
Gate at ● Gate at ●

● Curb Box

RECEIVED
JAN 15 2018
City of Glens Falls
W.W.T.P.

