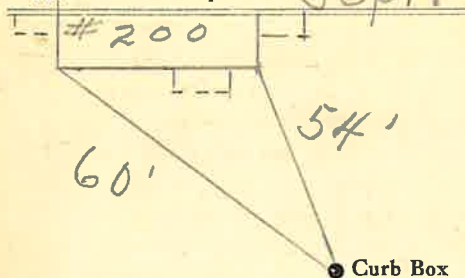
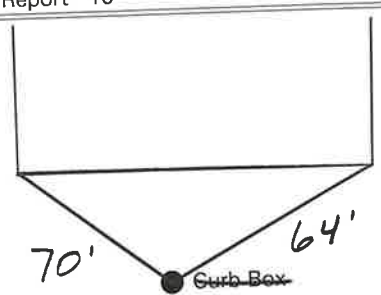


St. Ridge
 Ave. No. 200
 Name of Owner Breen
 Labor and Mat'l. Report Sept. 21 19 55

 6" Main Elev. of Main at tap 5'
 Gate at • • Gate at
 • Curb Box
3/4" - 30' copper
 L.M-5C-2-1-54

200 RIDGE St
 Ave. No. _____
 Name of Owner _____
 TAX ID # 302.16-16-2
 Labor and Mat'l. Report 19 _____

 CLEANOUT
 Main Elev. of Main at tap _____
 Gate at • • Gate at
 • Curb Box

RECEIVED
JAN 15 2018
City of Glens Falls
W.W.T.P.

LABOR AND MATERIALS

1 Copper } Connection ^{3/4"} \$ 2.71
 -Lead }
 1 Curb { Cock } 3/4 in. \$ 3.83
 { Valve }
 { T.S. & V. }
 Same Service box { Short 3 1/2 x 4 1/2 }
 -Old returned { Long 4 1/2 x 5 1/2 }
 { Buff. or Rdway } \$
 30 Ft. 3/4 in. { Copper } Pipe at 45 \$ 13.50
 { G.I. }
 { C.I. }
 Nipples _____ in. at _____ \$
 Bushings _____ to _____ in. at _____ \$
 Red'g }
 Inc'g } Coupl'gs _____ to _____ in. at _____ \$
 Union _____ in. at _____ \$
 Meter _____ in. at _____ \$
 Lead Joints at _____ \$
 Compound Joints at _____ \$
 Maintenance Foreman _____ \$
 Hrs. Water Maint. Man-1 at _____ \$
 10 Hrs. Water Maint. Man-2 at 1.24 \$ 12.40
 4 Hrs. Garage Foreman at 1.59 \$ 6.36
 15 Hrs. Labor at 1.13 \$ 16.95
 Hrs. Compressor at _____ \$
 Compensation Ins. at \$4.29 per C \$ 1.53
 Trucking _____ \$ 1.50
 Pav't Patch \$ 4.72
 Top by Gissard
 9-21-55 \$
 O'head _____ \$
 \$ 95.30

60.55

LABOR AND MATERIALS

Copper } Connection _____ \$
 Lead }
 Curb { Cock } _____ in. \$
 { Valve }
 { T.S. & V. }
 Service box { Short 3-1/2 x 4-1/2 } \$
 Old returned { Long 4-1/2 x 5-1/2 } \$
 Ft. _____ in. { Copper } Pipe at _____ \$
 { G.I. }
 { C.I. }
 Nipples _____ in. at _____ \$
 Bushings _____ to _____ in. at _____ \$
 Red'g _____
 Inc'g _____
 Union _____ in. at _____ \$
 Meter _____ in. at _____ \$
 _____ \$
 Compound Joints at _____ \$
 Maintenance Foreman _____ \$
 Hrs. Water Maint. Man - 1 at _____ \$
 Hrs. Water Maint. Man - 2 at _____ \$
 Hrs. Garage Foreman _____ at _____ \$
 Hrs. Labor _____ at _____ \$
 Hrs. Compressor at _____ \$
 _____ \$
 Trucking _____ \$
 Pav't Patch _____ \$
 _____ \$
 _____ \$
