

31-171


202

Labor and Material Report

June 18

1931

3/4" tap at 154 Ridge at

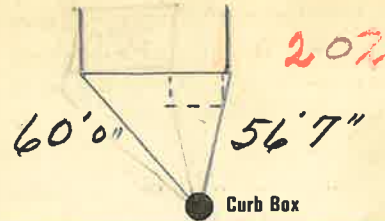

6" Main

Elev of Main at tap 4'2 1/2

Gate at ●

● Gate at

● Curb Box

Old tap shut off

3/4" - 26' copper

202 RIDGE




Pl. Ave. No. _____

Name of Owner _____

TAX ID # 302.116-16-3

Labor and Mat'l. Report 19

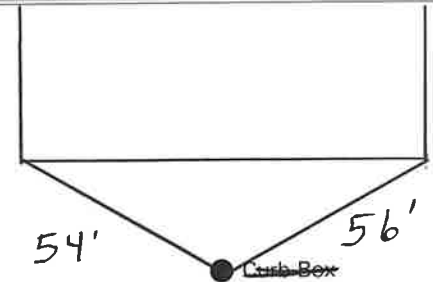

CLEANOUT

Elev. of Main at tap _____

_____ Main

Gate at ●

● Gate at

● Curb Box

RECEIVED

JAN 15 2018

City of Glens Falls
W.W.T.P.

