

203 RIDGE


SP

Pl. Ave. No.

Name of Owner

TAX ID # 303.13-8-19

Labor and Mat'l. Report 19

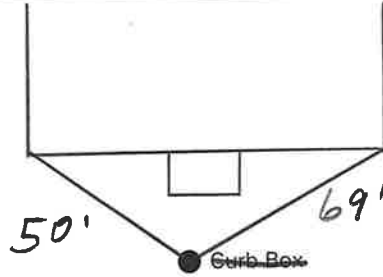

CLEANOUT

_____ Main Elev. of Main at tap _____

Gate at ● ● Gate at

● Curb Box

RECEIVED

JAN 15 2018

City of Glens Falls
W.W.T.P.

31-172 201-203

Labor and Material Report 18

1921

3/4 tap at 155 Ridge at


201-203

See below.



6" Main Elev. of Main at tap 442.12

Gate at ● 3/4" - 18' COPPER ● Gate at

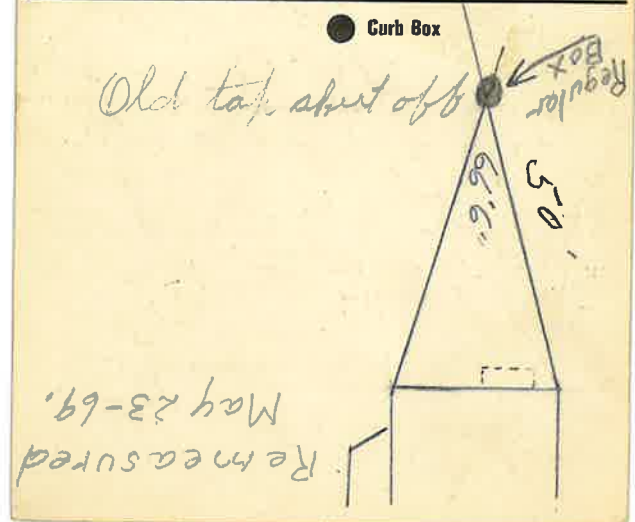

LABOR AND MATERIALS

_____	Copper } Connection _____	\$ _____
_____	Lead } _____	\$ _____
_____	Curb } Cock Valve } _____ in.	\$ _____
	} T.S. & V. }	
_____	Service box { Short 3-1/2 x 4-1/2 }	\$ _____
_____	Old returned { Long 4-1/2 x 5-1/2 }	\$ _____
_____	Ft. _____ in. { Copper } Pipe at _____	\$ _____
	} G.I. }	
	} C.I. }	
_____	Nipples _____ in. at _____	\$ _____
_____	Bushings _____ to _____ in. at _____	\$ _____
_____	Red'g _____	\$ _____
_____	Inc'g _____	\$ _____
_____	Union _____ in. at _____	\$ _____
_____	Meter _____ in. at _____	\$ _____
_____	_____	\$ _____
_____	Compound Joints at _____	\$ _____
_____	Maintenance Foreman _____	\$ _____
_____	Hrs. Water Maint. Man - 1 at _____	\$ _____
_____	Hrs. Water Maint. Man - 2 at _____	\$ _____
_____	Hrs. Garage Foreman _____ at _____	\$ _____
_____	Hrs. Labor _____ at _____	\$ _____
_____	Hrs. Compressor at _____	\$ _____
_____	_____	\$ _____
_____	Trucking _____	\$ _____
_____	Pav't Patch _____	\$ _____
_____	_____	\$ _____
_____	_____	\$ _____
Labor and Materials

1	Copper } Connection <i>3/4</i>	\$ <i>2.60</i>
	Lead } _____	
1	Curb } Cock Valve } <i>3/4</i> in.	\$ <i>2.27</i>
	} T.S. & V. }	
1	Service Box { Short <i>3 1/2 x 4 1/2</i> }	\$ <i>1.38</i>
	Old returned { Long <i>4 1/2 x 5 1/2</i> } Buff. or Rdway }	
<i>1.8</i>	Ft. <i>3 1/2</i> in. { Copper } Pipe at _____	\$ <i>3.24</i>
	} Galv. Iron }	
	} Cast Iron }	
_____	Nipples _____ in. at _____	\$ _____
_____	Bushings _____ to _____ in. at _____	\$ _____
_____	Red'g } Couplings _____ to _____ in. at _____	\$ _____
	Inc'g }	
_____	Union _____ in. at _____	\$ _____
_____	Meter _____ in. at _____	\$ _____
_____	Lbs. Br. Stone at _____	\$ _____
_____	Lbs. Sand at _____	\$ _____
_____	Bags Cement 'at _____	\$ _____
_____	Paving Brick { Mack } at _____	\$ _____
	} Red }	
	} Asphalt }	
_____	Lead Joints at _____	\$ _____
_____	Leadite Joints at _____	\$ _____
<i>5 1/2</i>	Hrs. Foreman at _____	\$ <i>2.44</i>
<i>2 1/2</i>	Hrs. Common Labor at _____	\$ <i>1.25</i>
<i>1.2 1/2</i>	Hrs. Common Labor at _____	\$ <i>5.63</i>
_____	Hrs. Mason at _____	\$ _____
_____	Hrs. Mason's Helper at _____	\$ _____
1	Hrs. Compressor at _____	\$ <i>1.50</i>
_____	Compensation Ins _____	\$ <i>32</i>
_____	Trucking _____	\$ <i>1</i>
_____	Builders' Use of Water <i>Patch</i>	\$ <i>23</i>
		Total \$ <i>45.43</i>