

205 RIDGE




Pl. Ave. No.

Name of Owner

TAX ID # 303.13-8-18

Labor and Mat'l. Report 19

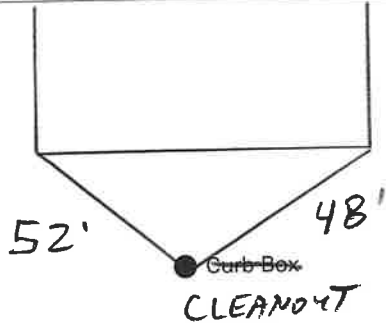

Main

Elev. of Main at tap

Gate at ●

● Gate at

● Curb Box

RECEIVED

JAN 15 2018

City of Glens Falls
W.W.T.P.

46-46

RIDGE

St. Pl.

205


Ave. No. 157

Name of Owner

Surprenant

Labor and Mat'l. Report

July 10 1946

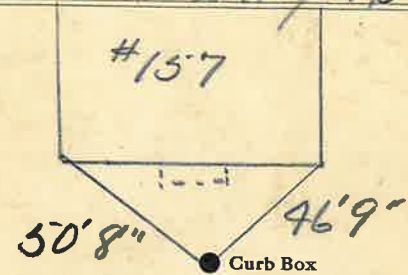

6 Main

Elev. of Main at tap

5-

Gate at ●

● Gate at

● Curb Box

3/4" - 13' COPPER

