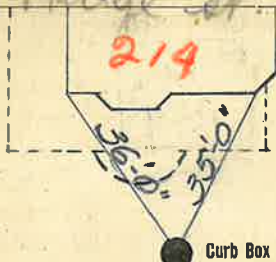

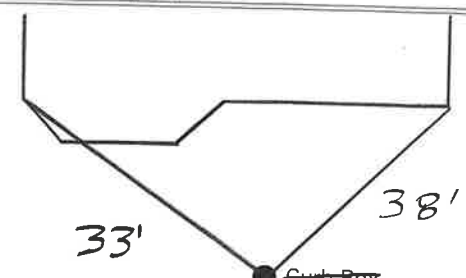


214
 Labor and Material Report 31 19
 166 Ridge St
 214

 Curb Box
 6" Main Elev. of Main at tap 4 1/2'
 Gate at 3/4" - 28' COPPER Gate at
 Curb Box
 No Measurement


214 RIDGE ST
 Ave. No. _____
 Name of Owner _____
 TAX ID # 302.16-14-3
 Labor and Mat'l. Report 19

 33' 38'
 Curb Box
 CLEANOUT
 Main Elev. of Main at tap _____
 Gate at ● Gate at ●
 Curb Box

RECEIVED
JAN 15 2018
 City of Glens Falls
 W.W.T.P.

