


216 RIDGE ^{SI}
Pl. Ave. No. _____

Name of Owner _____
TAX ID # 302.16-14-4

Labor and Mat'l. Report 19

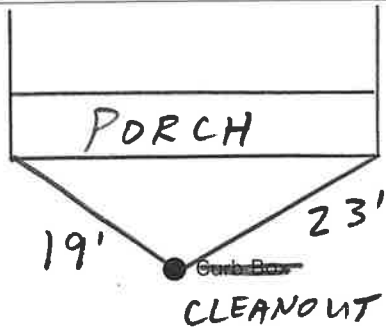

_____ Main Elev. of Main at tap _____
Gate at ● Gate at ●
_____ Curb Box

RECEIVED

JAN 15 2018

**City of Glens Falls
W.W.T.P.**

31-174 216
Labor and Material Report 19 1931
3/4" tap at 168 Ridge st
216
Curb Box
6" Main Elev. of Main at tap 4 1/2 ft
Gate at ● Gate at ●
Curb Box
Old tap about off
3/4" - 28' COPPER

LABOR AND MATERIALS

Copper	}	Connection	\$	
Lead				
Curb	}	Cock Valve	\$	
		T.S. & V.		
Service box	{	Short 3-1/2 x 4-1/2	\$	
Old returned		Long 4-1/2 x 5-1/2		
Ft. _____ in.	{	Copper	\$	
		G.I.		
		C.I.		
		Pipe at _____		
Nipples _____ in.		at _____	\$	
Bushings _____ to _____ in.		at _____	\$	
Red'g				
Inc'g				
Union _____ in.		at _____	\$	
Meter _____ in.		at _____	\$	
			\$	
Compound Joints at _____			\$	
Maintenance Foreman _____			\$	
Hrs. Water Maint. Man - 1 at _____			\$	
Hrs. Water Maint. Man - 2 at _____			\$	
Hrs. Garage Foreman _____ at _____			\$	
Hrs. Labor _____ at _____			\$	
Hrs. Compressor at _____			\$	
			\$	
Trucking _____			\$	
Pav't Patch _____			\$	
			\$	
			\$	
Labor and Materials

1	Copper	} Connection	\$	2.60
	Lead			
1	Curb	Cock Valve	\$	2.27
		T.S. & V.		
1	Service Box	Short 3 1/2 x 4 1/2	\$	1.39
	Old returned	Long 4 1/2 x 5 1/2		
		Buff. or Rdway		
28	Ft. 3/4	Copper Galv. Iron	\$	5.04
		Cast Iron		
	Nipples	in. at _____	\$	
	Bushings	_____ to _____ in. at _____	\$	
	Red'g		\$	
	Inc'g		\$	
	Union	_____ in. at _____	\$	
	Meter	_____ in. at _____	\$	
			\$	
	Lbs. Br. Stone	at _____	\$	
	Lbs. Sand	at _____	\$	
	Bags Cement	'at _____	\$	
	Paving Brick	{ Mack Red Asphalt } at _____	\$	
	Lead Joints	at _____	\$	
	Leadite Joints	at _____	\$	
10	Hrs. Foreman	at _____	\$	6.25
6	Hrs. Common Labor	Tapper	\$	3.00
25	Hrs. Common Labor	at _____	\$	11.25
	Hrs. Mason	at _____	\$	
	Hrs. Mason's Helper	at _____	\$	
3	Hrs. Compressor	at _____	\$	4.50
	Compensation Ins.		\$	6.30
	Trucking		\$	1.00
	Builders' Use of Water		\$	20.00
Total				\$60.92