


217 RIDGE

SP
Pl. Ave. No.

Name of Owner

TAX ID # 303.13-1-24

Labor and Mat'l. Report 19

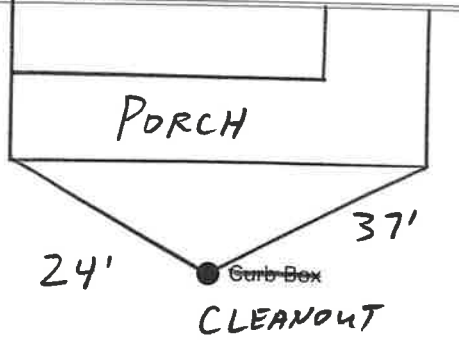

Main _____ Elev. of Main at tap _____
 Gate at ● ● Gate at

● Curb Box


RECEIVED
JAN 15 2018
 City of Glens Falls
 W.W.T.P.

31-175 217

Labor and Material Report June 22

19 01

3/4" tap at 169 Ridge st

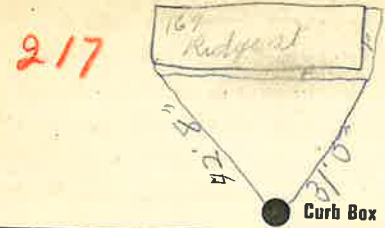

1" Main _____ Elev. of Main at tap 442 ft
 Gate at ● ● Gate at

● Curb Box

Old tap shut off

Old Connection Dept

3/4" - 12' COPPER

LABOR AND MATERIALS

Copper	}	Connection			\$	
Lead						
Curb	}	Cock	} in.		\$	
		Valve				
		T.S. & V.				
Service box	{	Short 3-1/2 x 4-1/2	}		\$	
Old returned		Long 4-1/2 x 5-1/2				
Ft. ____ in.	{	Copper	} Pipe at		\$	
		G.I.				
		C.I.				
Nipples		in. at			\$	
Bushings		to ____ in. at			\$	
Red'g						
Inc'g						
Union		in. at			\$	
Meter		in. at			\$	
					\$	
Compound Joints at					\$	
Maintenance Foreman					\$	
Hrs. Water Maint. Man - 1 at					\$	
Hrs. Water Maint. Man - 2 at					\$	
Hrs. Garage Foreman ____ at					\$	
Hrs. Labor ____ at					\$	
Hrs. Compressor at					\$	
					\$	
Trucking					\$	
Pav't Patch					\$	
					\$	
					\$	
Labor and Materials

1	Copper	}	Connection			\$	
	Lead						
1	Curb	}	Cock	} 3/4 in.		\$	
			Valve				
			T.S. & V.				
1	Service Box	{	Short 3 1/2 x 4 1/2	}		\$	
	Old returned		Long 4 1/2 x 5 1/2				
			Buff. or Rdway				
1.2	Ft. 3/4 in.	{	Copper	} Pipe at		\$	
			Galv. Iron				
			Cast Iron				
	Nipples		in. at			\$	
	Bushings		to ____ in. at			\$	
	Red'g	{	Inc'g	} Couplings		\$	
	Union		in. at			\$	
	Meter		in. at			\$	
	Lbs. Br. Stone at					\$	
	Lbs. Sand at					\$	
	Bags Cement at					\$	
	Paving Brick	{	Mack	} at		\$	
			Red				
			Asphalt				
	Lead Joints at					\$	
	Leadite Joints at					\$	
17 1/4	Hrs. Foreman at					\$	
4 1/2	Hrs. Common Labor at					\$	
20 1/2	Hrs. Common Labor at					\$	
	Hrs. Mason at					\$	
	Hrs. Mason's Helper at					\$	
2	Hrs. Compressor at					\$	
	Compensation Ins					\$	
	Trucking					\$	
	Builders' Use of Water					\$	

Total \$ 76.04