


LABOR AND MATERIALS

_____ Copper } Connection _____ \$ _____	
_____ Lead } _____	
_____ Curb } Cock _____ in. _____ \$ _____	
_____ } Valve _____	
_____ } T.S. & V. _____	
_____ Service box { Short 3-1/2 x 4-1/2 } _____ \$ _____	
_____ Old returned { Long 4-1/2 x 5-1/2 } _____	
_____ Ft. _____ in. { Copper } Pipe at _____ \$ _____	
_____ } G.I.	
_____ } C.I.	
_____ Nipples _____ in. at _____ \$ _____	
_____ Bushings _____ to _____ in. at _____ \$ _____	
_____ Red'g _____	
_____ Inc'g _____	
_____ Union _____ in. at _____ \$ _____	
_____ Meter _____ in. at _____ \$ _____	
_____ _____ \$ _____	
_____ Compound Joints at _____ \$ _____	
_____ Maintenance Foreman _____ \$ _____	
_____ Hrs. Water Maint. Man - 1 at _____ \$ _____	
_____ Hrs. Water Maint. Man - 2 at _____ \$ _____	
_____ Hrs. Garage Foreman _____ at _____ \$ _____	
_____ Hrs. Labor _____ at _____ \$ _____	
_____ Hrs. Compressor at _____ \$ _____	
_____ _____ \$ _____	
_____ Trucking _____ \$ _____	
_____ Pav't Patch _____ \$ _____	
_____ _____ \$ _____	
_____ _____ \$ _____	
218 RIDGE PI. Ave. No. _____

Name of Owner _____
TAX ID # 302.16-14-5

Labor and Mat'l. Report 19

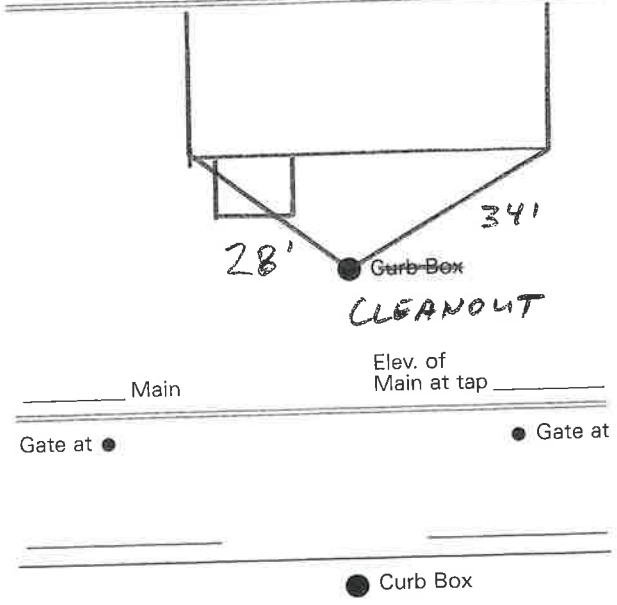

RECEIVED

JAN 15 2018

**City of Glens Falls
W.W.T.P.**