


219 RIDGE

Pl. Ave. No.

Name of Owner

TAX ID # 303.13-1-23

Labor and Mat'l. Report 19

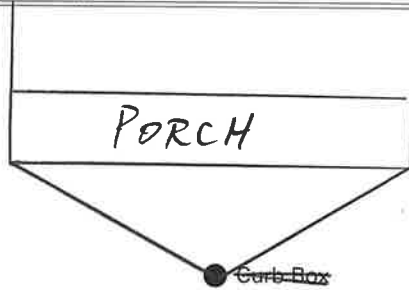

_____ Main Elev. of Main at tap _____

Gate at ● ● Gate at _____

● Curb Box

RECEIVED

JAN 15 2018

**City of Glens Falls
W.W.T.P.**

31-177

219

Labor and Material Report

June 26

1931

3/4" tap at 171 Ridge st



6" Main

Elev of Main at tap 4 1/2

Gate at ●

● Gate at _____

● Curb Box

Old tap shut off

3/4" - 12' COPPER

LABOR AND MATERIALS

Copper	}	Connection		\$	
Lead					
Curb	}	Cock Valve	} in.	\$	
		T.S. & V.			
Service box	}	Short 3-1/2 x 4-1/2	} _____	\$	
Old returned		Long 4-1/2 x 5-1/2			
Ft. _____ in.	}	Copper	} Pipe at _____	\$	
		G.I.			
		C.I.			
Nipples _____ in.		at _____		\$	
Bushings _____ to _____ in.		at _____		\$	
Red'g					
Inc'g					
Union _____ in.		at _____		\$	
Meter _____ in.		at _____		\$	
				\$	
Compound Joints at _____				\$	
Maintenance Foreman _____				\$	
Hrs. Water Maint. Man - 1 at _____				\$	
Hrs. Water Maint. Man - 2 at _____				\$	
Hrs. Garage Foreman _____ at _____				\$	
Hrs. Labor _____ at _____				\$	
Hrs. Compressor at _____				\$	
				\$	
Trucking _____				\$	
Pav't Patch _____				\$	
				\$	
				\$	
				\$	
				\$	

Labor and Materials

Copper	}	Connection		\$	
Lead					
1 Curb	}	Cock Valve	} 3/4 in.	\$	
		T.S. & V.			
1 Service Box	}	Short 3 1/2 x 4 1/2	} _____	\$	
Old returned		Long 4 1/2 x 5 1/2			
12 Ft. 3/4 in.	}	Copper	} Pipe at _____	\$	
		Galv. Iron			
		Cast Iron			
Nipples _____ in.		at _____		\$	
1 Bushings . 3/4" to 1/2" in.		at _____		\$.05
Red'g Inc'g	}	Couplings	} to _____ in. at _____	\$	
Union _____ in.		at _____		\$	
Meter _____ in.		at _____		\$	
Lbs. Br. Stone at _____				\$	
Lbs. Sand at _____				\$	
Bags Cement at _____				\$	
Paving Brick	}	Mack	} at _____	\$	
		Red			
		Asphalt			
Lead Joints at _____				\$	
Leadite Joints at _____				\$	
5 1/2 Hrs. Foreman at _____				\$	3.44
2 1/2 Hrs. Common Labor at _____		Tapper		\$	1.25
12 1/2 Hrs. Common Labor at _____				\$	5.63
Hrs. Mason at _____				\$	
Hrs. Mason's Helper at _____				\$	
1 Hrs. Compressor at _____				\$	1.50
Compensation Ins _____				\$.32
Trucking _____				\$	1.00
Builders' Use of Water		Patch		\$.23
				Total \$	44.60