

223 RIDGE


SP

Pl. Ave. No.

Name of Owner

TAX ID # 303.13-1-21

Labor and Mat'l. Report 19

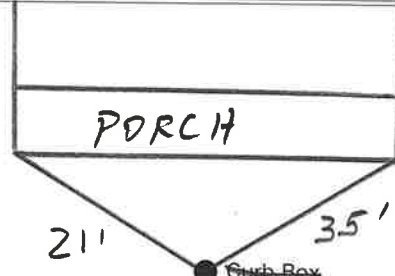

Main

Elev. of Main at tap

Gate at ●

● Gate at

● Curb Box

**RECEIVED**

**JAN 15 2018**

**City of Glens Falls  
W.W.T.P.**

31-179

223

Labor and Material Report

June 22

19 31

3/4" tap at 173 Ridge at

223



6" Main

Elev. of Main at tap 11/2 ft

Gate at ●

● Gate at

● Curb Box

Old tap shut off

3/4" - 12' COPPER

## LABOR AND MATERIALS

Copper	}	Connection	\$	
Lead				
Curb	}	Cock Valve T.S. & V.	\$	in. _____
Service box	{	Short 3-1/2 x 4-1/2	\$	
Old returned		Long 4-1/2 x 5-1/2		
Ft. _____	in. {	Copper G.I. C.I.	\$	Pipe at _____
Nipples		in. at _____	\$	
Bushings		to _____ in. at _____	\$	
Red'g				
Inc'g				
Union		in. at _____	\$	
Meter		in. at _____	\$	
			\$	
Compound Joints		at _____	\$	
Maintenance Foreman			\$	
Hrs. Water Maint. Man - 1		at _____	\$	
Hrs. Water Maint. Man - 2		at _____	\$	
Hrs. Garage Foreman		at _____	\$	
Hrs. Labor		at _____	\$	
Hrs. Compressor		at _____	\$	
			\$	
Trucking			\$	
Pav't Patch			\$	
			\$	
			\$	
## Labor and Materials

1	Copper	Connection	\$	2.60
	Lead			
1	Curb	Cock Valve T.S. & V.	\$	2.27
		in. _____		
1	Service Box	Short 3 1/2 x 4 1/2	\$	1.38
	Old returned	Long 4 1/2 x 5 1/2		
		Buff. or Rdway		
12	Ft. _____	in. { Copper Galv. Iron Cast Iron	\$	2.16
		Pipe at _____		
	Nipples	in. at _____	\$	
	Bushings	to _____ in. at _____	\$	
	Red'g Inc'g	Couplings	\$	
		to _____ in. at _____		
	Union	in. at _____	\$	
	Meter	in. at _____	\$	
	Lbs. Br. Stone	at _____	\$	
	Lbs. Sand	at _____	\$	
	Bags Cement	at _____	\$	
	Paving Brick	{ Mack Red Asphalt } at _____	\$	
	Lead Joints	at _____	\$	
	Leadite Joints	at _____	\$	
5 1/2	Hrs. Foreman	at _____	\$	3.44
2 1/2	Hrs. Common Labor	at Tapper	\$	1.25
12 1/2	Hrs. Common Labor	at _____	\$	5.63
	Hrs. Mason	at _____	\$	
	Hrs. Mason's Helper	at _____	\$	
1	Hrs. Compressor	at _____	\$	1.50
	Compensation Ins		\$	.37
	Trucking		\$	1-
	Builders' Use of Water		\$	73-
Total \$				44.55