


31-180 **225-**  
Labor and Material Report June 22 1931

3/4" tap at 177 Ridge st

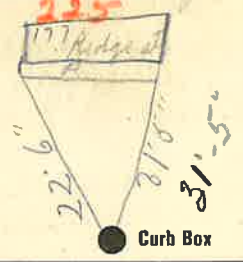

6" Main  
Elev of Main at tap 12 1/2'  
Gate at ● Gate at ●

● Curb Box

Old tap shut off

3/4" - 12' copper


**225 RIDGE**

SP  
Pl. Ave. No.

Name of Owner

TAX ID # 303.13-1-20

Labor and Mat'l. Report 19

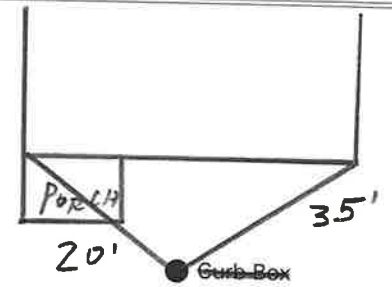

CLEANOUT

Main Elev. of Main at tap  
Gate at ● Gate at ●

● Curb Box

**RECEIVED**

**JAN 15 2018**

**City of Glens Falls  
W.W.T.P.**

### Labor and Materials

1	Copper	Lead	Connection	3/4		\$ 2.60
1	Curb	Cock Valve	T.S. & V.	3/4	in.	\$ 2.27
1	Service Box	Old returned	Short 3 1/2 x 4 1/2			\$ 1.38
			Long 4 1/2 x 5 1/2			
			Buff. or Rdway			
1.2	Ft.	3/4	in.	Copper Galv. Iron	Pipe at	\$ 2.16
				Cast Iron		
	Nipples		in. at			\$
1	Bushings	3/4	to 1/2	in. at		\$ 0.5
	Red'g	Inc'g	Couplings		to in. at	\$
	Union		in. at			\$
	Meter		in. at			\$
	Lbs. Br. Stone	at				\$
	Lbs. Sand	at				\$
	Bags Cement	at				\$
	Paving Brick	Mack Red Asphalt	at			\$
	Lead Joints	at				\$
	Leadite Joints	at				\$
5 1/2	Hrs. Foreman	at				\$ 3.44
2 1/2	Hrs. Common Labor	at				\$ 1.25
12 1/2	Hrs. Common Labor	at				\$ 5.63
	Hrs. Mason	at				\$
	Hrs. Mason's Helper	at				\$
1	Hrs. Compressor	at				\$ 1.50
	Compensation Ins.					\$ 32
	Trucking					\$ 1.00
	Builders' Use of Water	Patch				\$ 23.00
Total						\$ 44.60

### LABOR AND MATERIALS

_____	Copper	Lead	Connection	_____	\$ _____
_____	Curb	Cock Valve	T.S. & V.	_____ in.	\$ _____
_____	Service box	Old returned	Short 3-1/2 x 4-1/2	_____	\$ _____
			Long 4-1/2 x 5-1/2		
_____	Ft.	_____	in.	Copper G.I. C.I.	Pipe at _____ \$ _____
_____	Nipples	_____	in. at _____		\$ _____
_____	Bushings	_____	to _____	in. at _____	\$ _____
_____	Red'g				
_____	Inc'g				
_____	Union	_____	in. at _____		\$ _____
_____	Meter	_____	in. at _____		\$ _____
_____					\$ _____
_____	Compound Joints	at _____			\$ _____
_____	Maintenance Foreman	_____			\$ _____
_____	Hrs. Water Maint. Man - 1	at _____			\$ _____
_____	Hrs. Water Maint. Man - 2	at _____			\$ _____
_____	Hrs. Garage Foreman	_____	at _____		\$ _____
_____	Hrs. Labor	_____	at _____		\$ _____
_____	Hrs. Compressor	at _____			\$ _____
_____					\$ _____
_____	Trucking	_____			\$ _____
_____	Pav't Patch	_____			\$ _____
_____					\$ _____
_____					\$ _____
_____					\$ _____
_____					\$ _____