


228 RIDGE

St.
Pl.
Ave. No.

Name of Owner

TAX ID # 302.12-27-3

Labor and Mat'l. Report 19

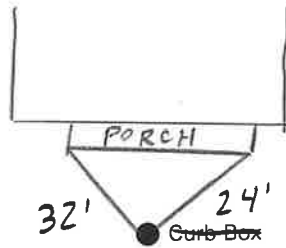

CLEANOUT

_____ Main Elev. of Main at tap _____

Gate at ●

● Gate at

● Curb Box

RECEIVED

JAN 15 2018

**City of Glens Falls
W.W.T.P.**

51-181 228
Labor and Material Report June 22 1931

3/4 tap at 178 Ridge st



6 Main Elev. of Main at tap 4 1/2

Gate at ● 29' to MAIN

● Gate at

● Curb Box

Old tap shut off.

LABOR AND MATERIALS

_____	Copper	} Connection	_____	\$	_____
_____	Lead	} _____	_____	\$	_____
_____	Curb	} Cock	} _____ in.	\$	_____
		} Valve			
		} T.S. & V.			
_____	Service box	{ Short 3-1/2 x 4-1/2	} _____	\$	_____
_____	Old returned				
_____	Ft. _____ in.	{ Copper	} Pipe at _____	\$	_____
		C.I.			
_____	Nipples	_____ in. at _____		\$	_____
_____	Bushings	_____ to _____ in. at _____		\$	_____
_____	Red'g	_____		\$	_____
_____	Inc'g	_____		\$	_____
_____	Union	_____ in. at _____		\$	_____
_____	Meter	_____ in. at _____		\$	_____
_____				\$	_____
_____	Compound Joints	at _____		\$	_____
_____	Maintenance Foreman	_____		\$	_____
_____	Hrs. Water Maint. Man - 1	at _____		\$	_____
_____	Hrs. Water Maint. Man - 2	at _____		\$	_____
_____	Hrs. Garage Foreman	_____ at _____		\$	_____
_____	Hrs. Labor	_____ at _____		\$	_____
_____	Hrs. Compressor	at _____		\$	_____
_____				\$	_____
_____	Trucking	_____		\$	_____
_____	Pav't Patch	_____		\$	_____
_____				\$	_____
_____				\$	_____
Labor and Materials

1	Copper	} Connection	3/4	\$	2.60
	Lead	} _____			
1	Curb	{ Cock	} 3/4 in.	\$	2.27
		T.S. & V.			
1	Service Box	{ Short 3 1/2 x 4 1/2	} _____	\$	1.38
	Old returned				
		Buff. or Rdway			
29	Ft. 3/4 in.	{ Copper	} Pipe at _____	\$	5.22
		Cast Iron			
	Nipples	_____ in. at _____		\$	_____
	Bushings	_____ to _____ in. at _____		\$	_____
	Red'g	_____		\$	_____
	Inc'g	_____		\$	_____
	Union	_____ in. at _____		\$	_____
	Meter	_____ in. at _____		\$	_____
	Lbs. Br. Stone	at _____		\$	_____
	Lbs. Sand	at _____		\$	_____
	Bags Cement	at _____		\$	_____
	Paving Brick	{ Mack	} at _____	\$	_____
		Asphalt			
	Lead Joints	at _____		\$	_____
	Leadite Joints	at _____		\$	_____
10	Hrs. Foreman	_____		\$	6.25
6	Hrs. Common Labor	at Tapper		\$	3.00
25	Hrs. Common Labor	at _____		\$	11.25
	Hrs. Mason	at _____		\$	_____
	Hrs. Mason's Helper	at _____		\$	_____
3	Hrs. Compressor	at _____		\$	4.50
	Compensation Ins.	_____		\$.63
	Trucking	_____		\$	1.00
	Builders' Use of Water	Patch		\$	20.00
Total					\$ 61.10