

Labor and Materials


1	Copper } Connection	2.60	
	Lead		
1	Curb } Cock Valve } 2 1/2 in.	2.30	
	T. S. & V.		
1	Service Box } Short 3 1/2 x 4 1/2	1.40	
	Old returned } Long 4 1/2 x 5 1/2		
		Buff. or Rdway	
2.5	Pt. } 3/4 in. } Copper	6.63	
		Galv. Iron	
		Cast Iron	
	Nipples	in. at	
	Bushings	to in. at	
	Red'g } Couplings	to in. at	
	Inc'g		
	Union	in. at	
	Meter	in. at	
	Lbs. Br. Stone	at	
	Lbs. Sand	at	
	Bags Cement	'at	
	Paving Brick } Mack	} at	
			Red
			Asphalt
	Lead Joints	at	
	Leadite Joints	at	
2 1/2	Hrs. Foreman	1.56	
1.0	Hrs. Common Labor	4.06	
	Hrs. Common Labor	at	
	Hrs. Mason	at	
	Hrs. Mason's Helper	at	
	Hrs. Compressor	at	
	Compensation Ins	1.15	
	Trucking	1.00	
	Builders' Use of Water	5.00	
		Patch	
	Total	24.70	

29-211

Labor and Material Report

12/6 1929

#3 Robertson St

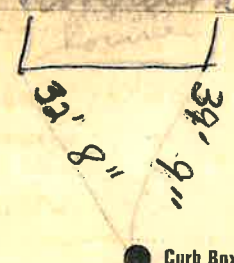

Main Elev of Main at tap 5"  
 Gate at 25' to MAIN Gate at

Curb Box

new job  
 3/4" copper  
 25' to MAIN  
 TAX 10# 309.7-12-27