


LABOR AND MATERIALS

1	Copper Lead	} Connection ^{3/4"}	\$
1	Curb		} Cock Valve } ^{3/4} in.
1	Service box	} { Short 3 1/2 x 4 1/2 } } { Long 4 1/2 x 5 1/2 } } Buff or Rdway }	
27	Ft. ^{3/4} in.		} { Copper } } { G.I. } } { C.I. }
	Nipples	in. at \$	
	Bushings	to in. at \$	
	Red'g Inc'g	} Coupl'gs to in. at \$	
	Union		in. at \$
	Meter	in. at \$	
	Lead Joints	at \$	
	Compound Joints	at \$	
	Maintenance Foreman	\$	
	Hrs. Water Maint. Man-1	at \$	
	Hrs. Water Maint. Man-2	at \$	
	Hrs. Garage Foreman	at \$	
	Hrs. Labor	at \$	
	Hrs. Compressor	at \$	
	Compensation Ins.	at \$ per C \$	
	Trucking	\$	
	Pav't Patch	\$	
	Tap by G.I. & Ford	\$	
	1st Co. 6-29-62	\$	
	O'head	\$	

Rogers St. Pt. Ave. No. 2

Name of Owner Lawrence Loveland

Labor and Mat'l. Report June 29 1962

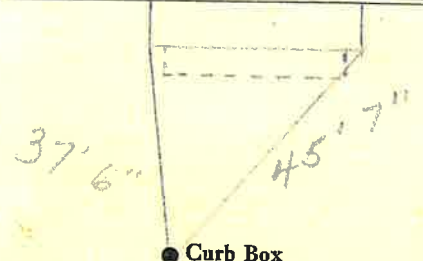

6" C.I. Main Elev. of Main at tap 4'
 Gate at • TAX ID # 303.18 • Gate at 15-110
 27' COPPER

● Curb Box
 old top to be dug up & disconnected from main
 7-5-62