


### Labor and Materials

Copper } Connection.....	\$.
Lead } .....	\$.
Curb { Cock } .....	in. \$.
{ Valve } .....	in. \$.
{ T. S. & V. } .....	in. \$.
Service Box } Short 3/4x1 1/2 } .....	\$.
Old returned } Long 4 1/2x5 1/2 } .....	\$.
{ Buff. or Rdway } .....	\$.
Ft. .... in. { Copper } Pipe at .....	\$.
{ Galv. Iron } .....	\$.
{ Cast Iron } .....	\$.
Nipples..... in. at .....	\$.
Bushings..... to .. in. at .....	\$.
Red'g } Couplings..... to .. in. at .....	\$.
Inc'g } .....	\$.
Union..... in. at .....	\$.
Meter..... in. at .....	\$.
Lbs. Br. Stone at .....	\$.
Lbs. Sand at .....	\$.
Bags Cement 'at .....	\$.
Paving Brick { Mack } at .....	\$.
{ Red } .....	\$.
{ Asphalt } .....	\$.
Lead Joints at .....	\$.
Leadite Joints at .....	\$.
Hrs. Foreman at .....	\$.
Hrs. Common Labor at .....	\$.
Hrs. Common Labor at .....	\$.
Hrs. Mason at .....	\$.
Hrs. Mason's Helper at .....	\$.
Hrs. Compressor at .....	\$.
Compensation Ins .....	\$.
Trucking.....	\$.
Builders' Use of Water .....	\$.
Total \$.....	

15 Rogers St

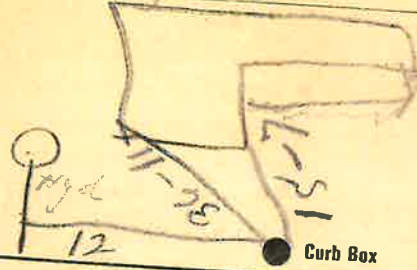

Main Elev of Main at tap

Gate at ● ● Gate at

● Curb Box

from Fire Hyd 12'  
 .. Corners Bldg. { 36'-11"  
                           { 15'-7"

9/22 - no # 15 on map