


LABOR AND MATERIALS

Copper	Lead	Connection	_____	\$	
Curb	Cock Valve	T. S. & V.	_____ in.	\$	
Service box	Old returned	Short 3½ x 4½ Long 4½ x 5½	_____	\$	
28' 10"	3/4 in.	Copper G.I. G.I.	Pipe at _____	\$	
Nipples	_____ in.	at _____		\$	
Bushings	_____ to _____	in. at _____		\$	
Red'g Inc'g	Coupl'gs	_____ to _____	in. at _____	\$	
Union	_____ in.	at _____		\$	
Meter	_____ in.	at _____		\$	
Compound Joints	_____ at _____			\$	
Maintenance Foreman	_____ at _____			\$	
Hrs. Water Maint. Man-1	_____ at _____			\$	
Hrs. Water Maint. Man-2	_____ at _____			\$	
Hrs. Garage Foreman	_____ at _____			\$	
Hrs. Labor	_____ at _____			\$	
Hrs. Compressor	_____ at _____			\$	
Trucking	_____ at _____			\$	
Pav't Patch	_____ at _____			\$	
				\$	
				\$	
St. _____
Pl. _____
Ave. No. 16

Rogers
Name of Owner _____

Labor and Mat'l. Report _____ 1971

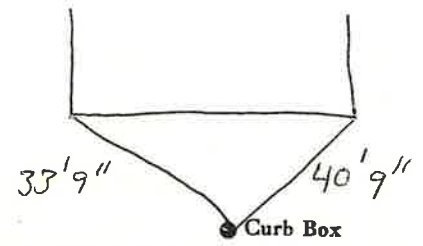

_____ Main Elev. of
Main at tap _____

Gate at • • Gate at

16-18 TAX ID# 303.18-15-9

● Curb Box

3/4" - 28' 10" COPPER

Labor and Materials

Copper	Connection.....	3	\$ 1.25
Lead		4	
Curb	{ Cock Valve P.S.&V. }in	3	\$ 1.70
Service Box	{ Short 3 1/4 x 4 1/4 }		
Old returned	{ Long 4 1/2 x 5 1/2 }		\$ 1.45
	{ Briff. or Rdway }		
28 Ft. 3/4 in.	{ Copper Galv. Iron Cast Iron } Pipe at 1.31x		\$ 3.78
Nipplesin. at		\$
Bushingstoin. at		\$
Red'g Inc'g	{ Couplings.....to.....in. at		\$
Unionin. at		\$
Meterin. at		\$
Lbs. Br. Stone	at		\$
Lbs. Sand	at		\$
Bags Cement	at		\$
Paving Brick	{ Mack Red Asphalt } at		\$
Lead Joints	at		\$
Leadite Joints	at		\$
9 Hrs. Foreman	at 6.71x		\$ 5.63
1A Hrs. Common Labor	at .45		\$ 6.30
Hrs. Common Labor	at		\$
Hrs. Mason	at		\$
Hrs. Masons Helper	at		\$
Hrs. Compressor	at		\$
Compensation Ins			\$.45
Trucking			\$ 1.-
Builders Use of Water	Patch		\$ 5.-


Total \$ 76.56

1935-16

Labor and Material Report

Cipi 25 1935

16 Rogers St

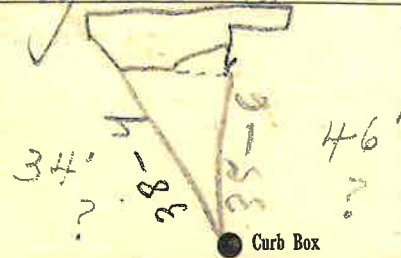

6 Main

Elev. of Main at tap 5

Gate at ●

● Gate at

● Curb Box

old shut off at
Main
16-18 TAX 10# 303.18-15-9

18 ROGERS ST.

HAS OUTSIDE CLEAN

OUT. 3/4" - 28' COPPER

Has 16 A
on house
#18 in computer