

LABOR AND MATERIALS

Copper } Connection _____ \$ _____
 Lead }
 Curb } Cock Valve } _____ in. _____ \$ _____
 T.S. & V. }
 Service box { Short 3-1/2 x 4-1/2 } _____ \$ _____
 Old returned { Long 4-1/2 x 5-1/2 }
 Ft. _____ in. { Copper } Pipe at _____ \$ _____
 { G.I. }
 { C.I. }
 Nipples _____ in. at _____ \$ _____
 Bushings _____ to _____ in. at _____ \$ _____
 Red'g _____
 Inc'g _____
 Union _____ in. at _____ \$ _____
 Meter _____ in. at _____ \$ _____
 _____ \$ _____
 Compound Joints at _____ \$ _____
 Maintenance Foreman _____ \$ _____
 Hrs. Water Maint. Man - 1 at _____ \$ _____
 Hrs. Water Maint. Man - 2 at _____ \$ _____
 Hrs. Garage Foreman _____ at _____ \$ _____
 Hrs. Labor _____ at _____ \$ _____
 Hrs. Compressor at _____ \$ _____
 _____ \$ _____
 Trucking _____ \$ _____
 Pav't Patch _____ \$ _____
 _____ \$ _____
 _____ \$ _____
 _____ \$ _____
 _____ \$ _____

Geer Tap

St. _____
 Pl. _____
 Ave. No. 21


Roger St.

Name of Owner

Ames Chemical Works

Labor and Mat'l. Report 12/8/06

Back Blue Building

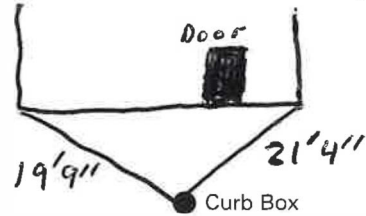

_____ Main Elev. of Main at tap _____
 Gate at ● Gate at ●

● Curb Box

Spare curb stop close to building. (main curb stop for line is outside of fence. Cohens Scrap metal was on it.)

2" Curb Stop

LABOR AND MATERIALS

1 Copper } Connection 1 1/2" \$
 lead }
 1 Curb } Cock } 2 in. OXISEAL \$
 Valve }
 T.S. & V. }
 1 Service box { Short 3 1/2 x 4 1/2 }
 Old returned { Long 4 1/2 x 5 1/2 } \$
 Buff or Rdway }
 30 Ft. 2 in. { Copper } Pipe at \$
 { G.I. }
 { G.I. }
 Nipples in. at \$
 Bushings to in. at \$
 Red'g }
 Inc'g } Coupl'gs to in. at \$
 Union in. at \$
 Meter in. at \$
 1 Lead Joints at 2" 3pc. Coupling \$
 1 Compound Joints at 2" Brass Coupling \$
 Maintenance Foreman \$
 Hrs. Water Maint. Man-1 at \$
 Hrs. Water Maint. Man-2 at \$
 Hrs. Garage Foreman at \$
 1 Hrs. Labor 2" Male Adapter \$
 Hrs. Compressor at \$
 Compensation Ins. at \$ per C \$
 Trucking \$
 Pav't Patch \$
 Tap By Beecher & Co \$
 April-4-1976 \$
 O'head \$

This TAP ON Geer St

Rogor

St.


Ave. No. 21

Name of Owner

G. A. F. Corp.

Labor and Mat'l. Report

April 3 1976

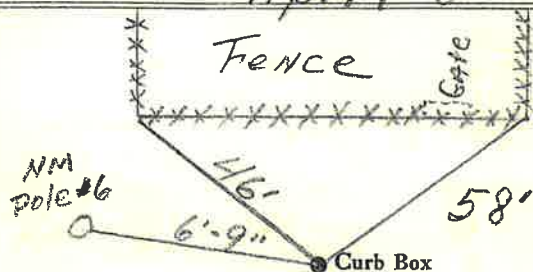

6" Main

Elev. of Main at tap 4'

Gate at ●

● Gate at

● Curb Box

TAP ON SIDE OF MAIN

2" - 30' copper

LSM-5C-6-1-67

This TAP ON Geer St

LABOR AND MATERIALS


1	Copper	Connection	1"		\$
1	Lead	Cock	1 in.		\$
1	Curb	Valve			\$
		T.S. & V.			\$
1	Service box	Short 3 1/2 x 4 1/2			\$
31	Old returned	Long 4 1/2 x 5 1/2			\$
		Buff or Rdway			\$
36	Ft. 1 in.	Copper			\$
		G.I.			\$
		G.I.			\$
		Pipe at			\$
	Nipples	in. at			\$
	Bushings	to in. at			\$
	Red'g	Coupl'gs	to in. at		\$
	Inc'g				\$
	Union	in. at			\$
	Meter	in. at			\$
	Lead Joints at				\$
	Compound Joints at				\$
	Maintenance Foreman				\$
	Hrs. Water Maint. Man-1 at				\$
	Hrs. Water Maint. Man-2 at				\$
	Hrs. Garage Foreman at				\$
	Hrs. Labor at				\$
	Hrs. Compressor at				\$
	Compensation Ins. at \$		per C.		\$
	Trucking				\$
	Pav't Patch				\$
	Tap by Giffard & Co.				\$
	7-7-67.				\$
	O'head				\$

Geer St Tap

St. _____
Pl. _____
Ave. No. 21

Roger
Name of Owner
Ames Chemical Co.

Labor and Mat'l. Report July 7 1967

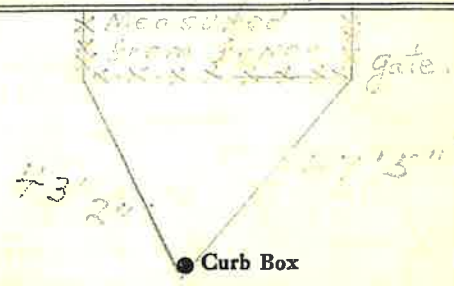

6" Main Elev. of Main at tap 4'
Gate at ● ● Gate at

● Curb Box
This tap is on
Geer St.
1" - 31' copper


LABOR AND MATERIALS

Copper } Connection _____ \$
 Lead }
 1 Curb } Cook-Valve } 6" in. M.J. \$
 } T.S. & V. }
 1 Service box { Short 3 1/2 x 4 1/2 }
 Old returned { Long 4 1/2 x 5 1/2 } 5' LONG \$
 } Buff or Rdway }
 6 1/2 Ft. 6 in. { Copper } Pipe at _____ \$
 } C.I. }
 } C.I. }
 Nipples _____ in. at _____ \$
 Bushings _____ to _____ in. at _____ \$
 Red'g }
 Inc'g } Coupl'gs _____ to _____ in. at _____ \$
 Union _____ in. at _____ \$
 Meter _____ in. at _____ \$
 Lead Joints at _____ \$
 Compound Joints at _____ \$
 Maintenance Foreman _____ \$
 Hrs. Water Maint. Man-1 at _____ \$
 Hrs. Water Maint. Man-2 at _____ \$
 Hrs. Garage Foreman _____ at _____ \$
 Hrs. Labor _____ at _____ \$
 Hrs. Compressor at _____ \$
 Compensation Ins. at \$ _____ per C _____ \$
 Trucking _____ \$
 Pav't Patch _____ \$
 Tap by *Waco* _____ \$
 2-26-70 _____ \$
 O'head _____ \$
 1-6"-1/16 Bend M.J. _____ \$

St. _____
 Pl. _____
 Ave. No. *21*

Name of Owner
Ames Chemical Wks.

Labor and Mat'l. Report *Feb. 26 1970*

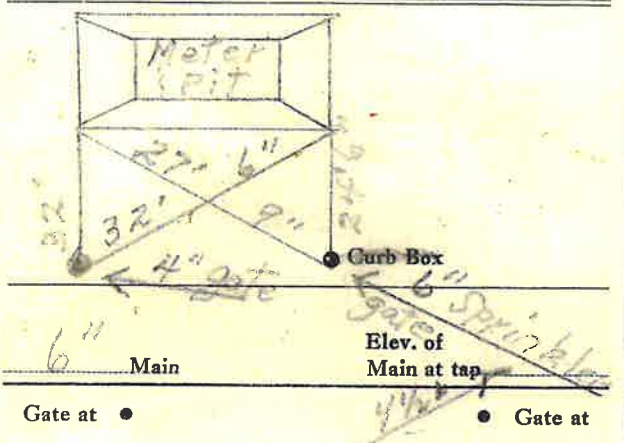

TAX ID # 303.18-8-1

● Curb Box
 6" CI
 6 1/2' copper

