


Labor and Materials

1	Copper	} Connection.....	\$1.50	
	Lead				
1	Curb	}in	\$1.70	
	Cock				
	Valve P.S.&V.				
1	Service Box	} Short 3 1/2 x 4 1/2	\$1.44	
	Old returned				} Long 4 1/2 x 5 1/2
		} Both of 14" dia.			
14	Ft.	} in { Copper Galv. Iron } Pipe at	\$2.66	
					} Cast Iron
	Nipplesin. at	\$	
	Bushingstoin. at.....	\$	
	Red'g Inc'g	} Couplings.....to.....in. at.....	\$	
	Unionin. at	\$	
	Meterin. at	\$	
	Lbs. Br. Stone	at	\$	
	Lbs. Sand	at	\$	
	Bags Cement	at	\$	
	Paving Brick	} at	\$	
					} Mack
					} Red Asphalt
	Lead Joints	at	\$	
	Leadite Joints	at	\$	
1	Hrs. Foreman	at	\$ 0.63	
7	Hrs. Common Labor	at .. 45	\$ 3.15	
	Hrs. Common Labor	at	\$	
	Hrs. Mason	at	\$	
	Hrs. Masons Helper	at	\$	
1	Hrs. Compressor	at	\$ 1.50	
	Compensation Ins	\$.14	
	Trucking	\$	
	Builders Use of Water	\$	
Total \$				12.72	

25-27 *Rogers Street*

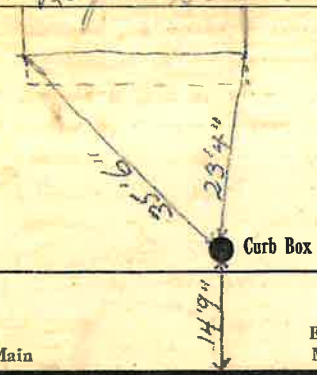

Gate at ● TAX 10th 303.18-8-2 ● Gate at

● Curb Box
old Tap shut off at main

John Yagi

14' copper

Yagi