


LABOR AND MATERIALS

Copper	} Connection	_____	\$ _____	
Lead				
Curb	} Cock } Valve } T. S. & V.	_____ in.	\$ _____	
Service box		} Short 3½ x 4½	_____	\$ _____
Old returned			\$ _____	
18 Ft.	} Copper } G.I. } G.I.	1 in. } Pipe at	\$ _____	
Nipples			_____ in. at	\$ _____
Bushings			_____ to _____ in. at	\$ _____
Red'g	} Coupl'gs	_____ to _____ in. at	\$ _____	
Inc'g				
Union	_____ in. at	\$ _____		
Meter	_____ in. at	\$ _____		
_____			\$ _____	
Compound Joints at			\$ _____	
Maintenance Foreman			\$ _____	
Hrs. Water Maint. Man—1 at			\$ _____	
Hrs. Water Maint. Man—2 at			\$ _____	
Hrs. Garage Foreman	_____ at		\$ _____	
Hrs. Labor—	_____ at		\$ _____	
Hrs. Compressor at			\$ _____	
_____			\$ _____	
Trucking			\$ _____	
Pav't Patch			\$ _____	
_____			\$ _____	
_____			\$ _____	
St. Rogers  
 Pt. 24  
 Ave. No. 24

Name of Owner \_\_\_\_\_

Labor and Mat'l. Report 1990

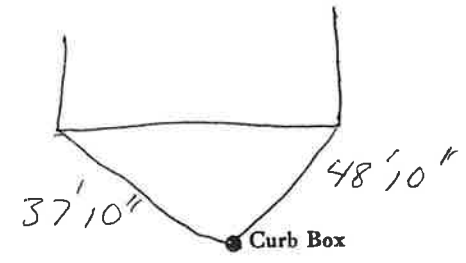

4 Main Elev. of Main at tap \_\_\_\_\_

Gate at • Gate at •

#26-TAX 10# 303.18-9-21

• Curb Box

1" - 18' COPPER

9122 - No 24 on map