

LABOR AND MATERIALS

Copper } Connection _____	\$ _____
Lead } _____	
Curb } Cock _____	\$ _____
} Valve _____	
} T. S. & V. _____	in. _____
Service box } Short 3½ x 4½ } _____	
Old returned } Long 4½ x 5½ } _____	\$ _____
Ft. 3/4 in. } Copper } Pipe at _____	\$ _____
} G.I. } _____	
} C.I. } _____	
Nipples _____ in. at _____	\$ _____
Bushings _____ to _____ in. at _____	\$ _____
Red'g } _____	
Inc'g } Coupl'gs _____ to _____ in. at _____	\$ _____
Union _____ in. at _____	\$ _____
Meter _____ in. at _____	\$ _____
_____	\$ _____
Compound Joints at _____	\$ _____
Maintenance Foreman _____	\$ _____
Hrs. Water Maint. Man—1 at _____	\$ _____
Hrs. Water Maint. Man—2 at _____	\$ _____
Hrs. Garage Foreman _____ at _____	\$ _____
Hrs. Labor— _____ at _____	\$ _____
Hrs. Compressor at _____	\$ _____
_____	\$ _____
Trucking _____	\$ _____
Pav't Patch _____	\$ _____
_____	\$ _____
_____	\$ _____
_____	\$ _____
_____	\$ _____

Roger


St. \_\_\_\_\_  
 Pl. \_\_\_\_\_  
 Ave. No. 28

Name of Owner \_\_\_\_\_

TAX ID # 303.18-9-20

Labor and Mat'l. Report

19 88

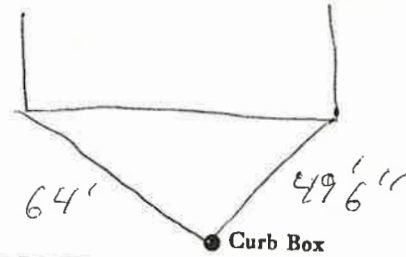

_____ Main	Elev. of
	Main at tap _____
Gate at ●	● Gate at _____
_____	
_____	
	● Curb Box

3/4" copper