


LABOR AND MATERIALS

Copper	} Connection	_____	\$ _____		
Lead					
Curb	} Cock	_____ in.	\$ _____		
				} Valve	
					} T. S. & V.
Service box	} Short 3½ x 4½	_____	\$ _____		
				Old returned	} Long 4½ x 5½
25 Ft.	1 in.	} Pipe at	\$ _____		
				} Copper	
					} G.I.
		} G.I.	\$ _____		
Nipples	_____ in.			at	\$ _____
Bushings	_____ to	_____ in.	at	\$ _____	
Red'g	} Coupl'gs	_____ to	_____ in.	at	\$ _____
Inc'g					
Union	_____ in.	at	\$ _____		
Meter	_____ in.	at	\$ _____		
Compound Joints	at	\$ _____			
Maintenance Foreman	\$ _____				
Hrs. Water Maint. Man—1	at	\$ _____			
Hrs. Water Maint. Man—2	at	\$ _____			
Hrs. Garage Foreman	at	\$ _____			
Hrs. Labor	_____ at	\$ _____			
Hrs. Compressor	at	\$ _____			
Trucking	\$ _____				
Pav't Patch	\$ _____				
	\$ _____				
	\$ _____				
St. Roger  
 Pl. \_\_\_\_\_  
 Ave. No. 32

Name of Owner  
W. Desbines

Labor and Mat'l. Report Dec 1987

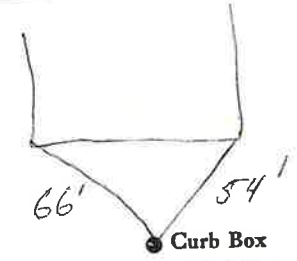

Main \_\_\_\_\_ Elev. of Main at tap \_\_\_\_\_  
 Gate at ● \_\_\_\_\_ Gate at \_\_\_\_\_

● Curb Box