

Labor and Material Report *Apr 26* 19*28*

3/4 Top 4 Rogers St

~~No Place to Measure from~~

See below.

● Curb Box

TAX 10 # 303.18-15-15

6" Main Elev. of Main at tap 4'

Gate at ● *3/4" 25' copper* ● Gate at


6" Main Elev. of Main at tap 4'

● Curb Box

See below.

~~No Place to Measure from~~

3/4 Top 4 Rogers St

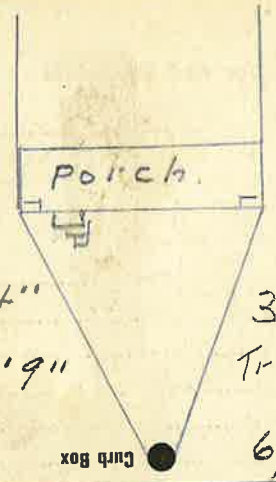

35' 4"
Try 35' 9"

31' 8"
Try 32'

6/20/1961

● Curb Box

Labor and Material Report *Apr 26* 19*28*

3/4 Top 4 Rogers St

~~No Place to Measure from~~

See below.

● Curb Box

TAX 10 # 303.18-15-15

6" Main Elev. of Main at tap 4'

Gate at ● *3/4" 25' copper* ● Gate at


6/20/1961

● Curb Box

35' 4"
Try 35' 9"

31' 8"
Try 32'

Brick Porch

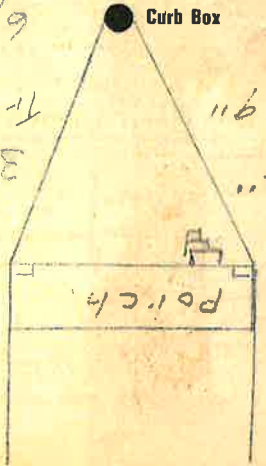

35' 4"
Try 35' 9"

31' 8"
Try 32'

6/20/1961

● Curb Box

Labor and Materials

3/4	Copper } Lead	Connection.....	\$ 3.20
1	Curb { Cock Valve T. S. & V. }	3/4 in.....	\$ 1.00
1	Service Box { Old returned	Short 2 1/2 x 4 1/2 Long 4 1/2 x 5 1/2 Buff. or Rdway }	\$ 1.40
25	Ft. 3/4 in. }	Copper Galv. Iron Cast Iron } Pipe at.....	\$
	Nipples.....	in. at.....	\$
	Bushings.....	to..... in. at.....	\$
	Red'g } Inc'g }	Couplings..... to..... in. at.....	\$
	Union.....	in. at.....	\$
	Meter.....	in. at.....	\$
	Lbs. Br. Stone at.....		\$
	Lbs. Sand at.....		\$
	Bags Cement at.....		\$
	Paving Brick { Mack Red Asphalt }	at.....	\$
	Lead Joints at.....		\$
	Leadite Joints at.....		\$
4	Hrs. Foreman at.....		\$ 2.00
10	Hrs. Common Labor at.....		\$ 4.06
	Hrs. Common Labor at.....		\$
	Hrs. Mason at.....		\$
	Hrs. Mason's Helper at.....		\$
	Hrs. Compressor at.....		\$
	Compensation Ins.....		\$.17
	Trucking.....		\$ 1.00
	Builders' Use of Water.....		\$

Total \$ 13.33