


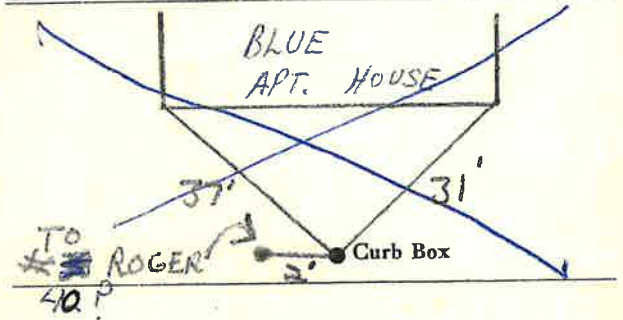
LABOR AND MATERIALS

Copper	} Connection	_____	\$ _____	
Lead				
Curb	} Cock Valve } T. S. & V. }	_____ in.	\$ _____	
Service box		} Short 3½ x 4½ } Long 4½ x 5½ }		
Old returned			Buff or Rdway	\$ _____
Ft.  in.	} Copper } G.I. } C.I. }	Pipe at	\$ _____	
Nipples		in. at	\$ _____	
Bushings	to _____ in.	at _____	\$ _____	
Red'g } Inc'g }	} Coupl'gs	to _____ in.	at _____ \$ _____	
Union		in. at	\$ _____	
Meter	in. at	\$ _____		
Lead Joints	at	\$ _____		
Compound Joints	at	\$ _____		
Maintenance Foreman		\$ _____		
Hrs. Water Maint. Man-1	at	\$ _____		
Hrs. Water Maint. Man-2	at	\$ _____		
Hrs. Garage Foreman	at	\$ _____		
Hrs. Labor	at _____	\$ _____		
Hrs. Compressor	at	\$ _____		
Compensation Ins.	at \$ _____ per C	\$ _____		
Trucking		\$ _____		
Pav't Patch		\$ _____		
		\$ _____		
		\$ _____		
O'head		\$ _____		
		\$ _____		

Rogers St. 38  
Pr.  
Ave. No.

Name of Owner  
Steve Miles

Labor and Mat'l. Report June 1986



..... Main Elev. of Main at tap.....  
 Gate at • Gate at

TAX ID # 303.18-9-16

• Curb Box #  
 see Card for 40  
 Roger #40 & #38  
 same  
 shot off @ #38