

LABOR AND MATERIALS


Copper } Connection _____	\$ _____
Lead } _____	\$ _____
Curb } Cock Valve } _____ in.	\$ _____
	T. S. & V. } _____
Service box } Short 3½ x 4½ }	\$ _____
Old returned } Long 4½ x 5½ }	\$ _____
Ft. 1 in. } Copper } Pipe at _____	\$ _____
	G.I. } _____
	G.I. } _____
Nipples _____ in. at _____	\$ _____
Bushings _____ to _____ in. at _____	\$ _____
Red'g } Coupl'gs _____ to _____ in. at _____	\$ _____
Inc'g } _____	\$ _____
Union _____ in. at _____	\$ _____
Meter _____ in. at _____	\$ _____
Compound Joints at _____	\$ _____
Maintenance Foreman _____	\$ _____
Hrs. Water Maint. Man—1 at _____	\$ _____
Hrs. Water Maint. Man—2 at _____	\$ _____
Hrs. Garage Foreman _____ at _____	\$ _____
Hrs. Labor _____ at _____	\$ _____
Hrs. Compressor at _____	\$ _____
Trucking _____	\$ _____
Pav't Patch _____	\$ _____
_____	\$ _____
_____	\$ _____
_____	\$ _____
_____	\$ _____

Roger

St. Ave. No. 40

Name of Owner *A. Miles*

Labor and Mat'l. Report 19 87

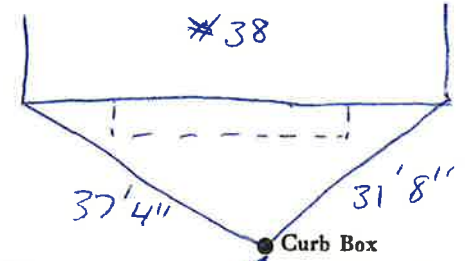

STOP for #40 Roger
Elev. of Main at tap

Gate at • #40 + #42 • Gate at

TAX 10th 303.18-9-15

Curb stop • Curb Box
Stop for #38 Roger

7" from other stop