


LABOR AND MATERIALS

Copper	} Connection _____	\$ _____	
Lead			
Curb	} Cock	\$ _____	
			} Valve
Service box	} Short 3½ x 4½	\$ _____	
Old returned			} Long 4½ x 5½
14 Ft. 1 in.	} Pipe at _____	\$ _____	
			} C.I.
			} C.I.
Nipples	in. at _____	\$ _____	
Bushings	to _____ in. at _____	\$ _____	
Red'g	} Coupl'gs _____ to _____ in. at _____	\$ _____	
Inc'g			
Union	in. at _____	\$ _____	
Meter	in. at _____	\$ _____	
		\$ _____	
Compound Joints	at _____	\$ _____	
Maintenance Foreman		\$ _____	
Hrs. Water Maint. Man-1	at _____	\$ _____	
Hrs. Water Maint. Man-2	at _____	\$ _____	
Hrs. Garage Foreman	at _____	\$ _____	
Hrs. Labor	at _____	\$ _____	
Hrs. Compressor	at _____	\$ _____	
		\$ _____	
Trucking		\$ _____	
Pav't Patch		\$ _____	
		\$ _____	
		\$ _____	
		\$ _____	

St. _____
 Pt. _____
 Ave. No. 41?
 Name of Owner
 Rogers
 Cifone -

Labor and Mat'l. Report _____ 1991

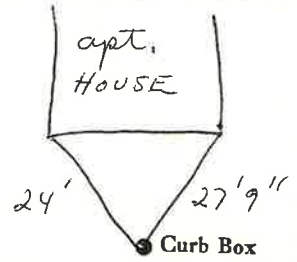

Main _____ Elev. of Main at tap _____
 Gate at • _____ Gate at _____

• Curb Box

Tap on Roger
 no 41 on map -
 9-15 Kathwick?