


LABOR AND MATERIALS

1	Copper	} Connection <sup>3/4"</sup>	\$
1	Lead		\$
1	Curb	} Cock Valve } <sup>3/4</sup> in.	\$
			T.S. & V.
1	Service box	} Short 3 1/2 x 4 1/2 } } Long 4 1/2 x 5 1/2 }	\$
	Old returned		Buff. or Rdway
26	<sup>3/4</sup> Ft. in.	} Copper } } G. I. } } C. I. }	Pipe at \$
	Nipples	in. at	\$
	Bushings	to in. at	\$
	Red'g } Inc'g }	Coupl'gs. to in. at	\$
	Union	in. at	\$
	Meter	in. at	\$
	Lead Joints	at	\$
	Compound Joints	at	\$
	Maintenance Foreman		\$
	Hrs. Water Maint. Man-1	at	\$
	Hrs. Water Maint. Man-2	at	\$
	Hrs. Garage Foreman	at	\$
	Hrs. Labor	at	\$
	Hrs. Compressor	at	\$
	Compensation Ins. at \$	per C.	\$
	Trucking		\$
	Pav't Patch		\$
	Tap by Giggord & Co.	2-14-63	\$
	O'head		\$
			\$

St. Rogers  
Pl. Ave. No. 6

Name of Owner Lee

Labor and Mat'l. Report Feb. 14 1963

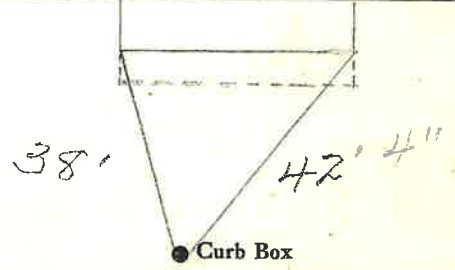

6" c.i. Main Elev. of Main at tap 4'

Gate at • Gate at  
TAX 10# 303.18-15-14

• Curb Box

3/4" - 26 COPPER