

LABOR AND MATERIALS

1	Copper Lead	Connection	3/4"	\$
1	Curb	Cock Valve T.S. & V.	3/4 in.	\$
1	Service box	Short 3 1/2 x 4 1/2		
	Old returned	Long 4 1/2 x 5 1/2		
		Buff or Rdway		\$
10	3/4 in.	Copper Pipe at		\$
	Nipples	in. at		\$
	Bushings	to in. at		\$
	Red'g			
	Inc'g	Coupl'gs. to in. at		\$
	Union	in. at		\$
	Meter	in. at		\$
	Lead Joints at			\$
	Compound Joints at			\$
	Maintenance Foreman			\$
	Hrs. Water Maint. Man—1 at			\$
	Hrs. Water Maint. Man—2 at			\$
	Hrs. Garage Foreman at			\$
	Hrs. Labor— at			\$
	Hrs. Compressor at			\$
	Compensation Ins. at \$	per C		\$
	Trucking			\$
	Pav't Patch			\$
	Tap by Gissard & Co.			\$
	4-30-58			\$
	O'head			\$

Rogers


St. ~~Pl.~~
Ave. No. 9

Name of Owner

Patterson Realty Co.

Labor and Mat'l. Report

Apr. 30 1958

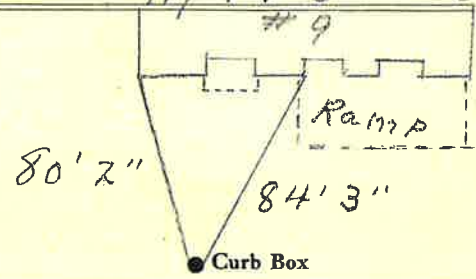

6" Main

Elev. of Main at tap 5'

Gate at ●

● Gate at

TAX ID# 303.18-142

● Curb Box

3/4" Tap.

10' COPPER


LABOR AND MATERIALS

Copper } Connection Ludlow \$
 Lead }
 1 Curb } Cock } 6 in. X 6" \$
 } Valve }
 } T.S. & V. }
 1 Service box } Short 3 1/2 x 4 1/2 }
 Old returned } Long 4 1/2 x 5 1/2 }
 } Buff or Rdway } \$
 16 1/2 Ft. 6 in. } Copper } Pipe at \$
 } G.I. }
 } C.I. }
 Nipples _____ in. at \$
 Bushings _____ to _____ in. at \$
 Red'g }
 Inc'g } Coupl'gs. _____ to _____ in. at \$
 Union _____ in. at \$
 Meter _____ in. at \$
 Lead Joints at \$
 Compound Joints at \$
 Maintenance Foreman \$
 Hrs. Water Maint. Man-1 at \$
 Hrs. Water Maint. Man-2 at \$
 Hrs. Garage Foreman _____ at \$
 Hrs. Labor _____ at \$
 Hrs. Compressor at \$
 Compensation Ins. at \$ _____ per C \$
 Trucking \$
 Pav't Patch \$
Tap by Miller Co \$
(6" cut by bareau) \$
 O'head \$
 \$

St. _____
 Pl. _____
 Ave. No. 9

Name of Owner
Patterson Realty Co.

Labor and Mat'l. Report Apr. 29 - 30 19 58

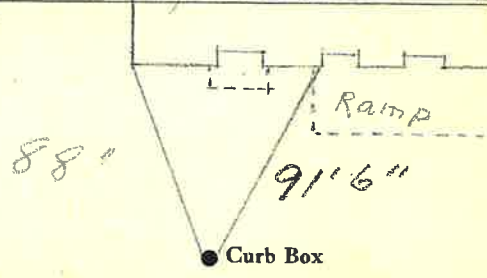

6" Main Elev. of Main at tap 5'
 Gate at • • Gate at

• Curb Box
6" Tap For
Sprinkler System
16 1/2" copper